

3:00

Washington County Health Department
 Courthouse Annex, 35 Public Square
 Salem, IN 47167
 312-883-5803

Application \$15.00 ()
 Receipt No. _____
 Permit \$35.00 ()
 Receipt No. _____

Application For Private Sewage Disposal System

Date: 2-18-98Applicant/Owner: Amzie D. TrayerPhone: 812-755-4212Mailing Address: 5702 S. Rosebud Rd.
Salem In. 47167Work: same

PROPOSED PROPERTY DESCRIPTION/LOCATION:

Load Location: _____
 Township: Madison
 Subdivision: _____
 Acreage: 55 1/2

Address No: 5702 Rosebud Rd.
 Town/City: Salem
 Section: 13
 Lot/Tract No.: _____

Are There Any Existing Dwellings on the Property? Y(✓) N()

Directions to Property: W. W. School Rd. To Rosebud Rd. West on
Rosebud to corner turn LEFT First drive on Right up
the hill to end of drive.

HOME DESCRIPTION: (check one)

Dwelling: House(✓) Modular () Mobile Home ()
 No. of Bedrooms: 1() 2() 3() 4(✓) Specify Other: _____
 Washer: Y(✓) N() Garbage Disposal Y() N(✓) *Wringer Washer
 Sump Pump: Y() N(✓) w/Plumbing Y() N()
 Water Supply: Public () Well (✓) Cistern ()

SIGNATURE: Amzie D. Trayer DATE: 2-18-98

Please Mark Front Of Property With A Sign Stating Name Or Lot Number. Also Mark Off Area Where
 The House Will Be Located. Colorful Flags Or Markings Would Be Appreciated.


THE FOLLOWING SECTION TO BE COMPLETED BY HEALTH DEPARTMENT

Septic tank minimum capacity 1250 gallons
 Field minimum distance to nearest well 50 feet
 minimum total effective absorption area 2000 sq. ft.
 total length of 3 foot trench lines _____

type 403 PGR Soils Evaluation sites (1,2,3)

PERMIT #

98.65

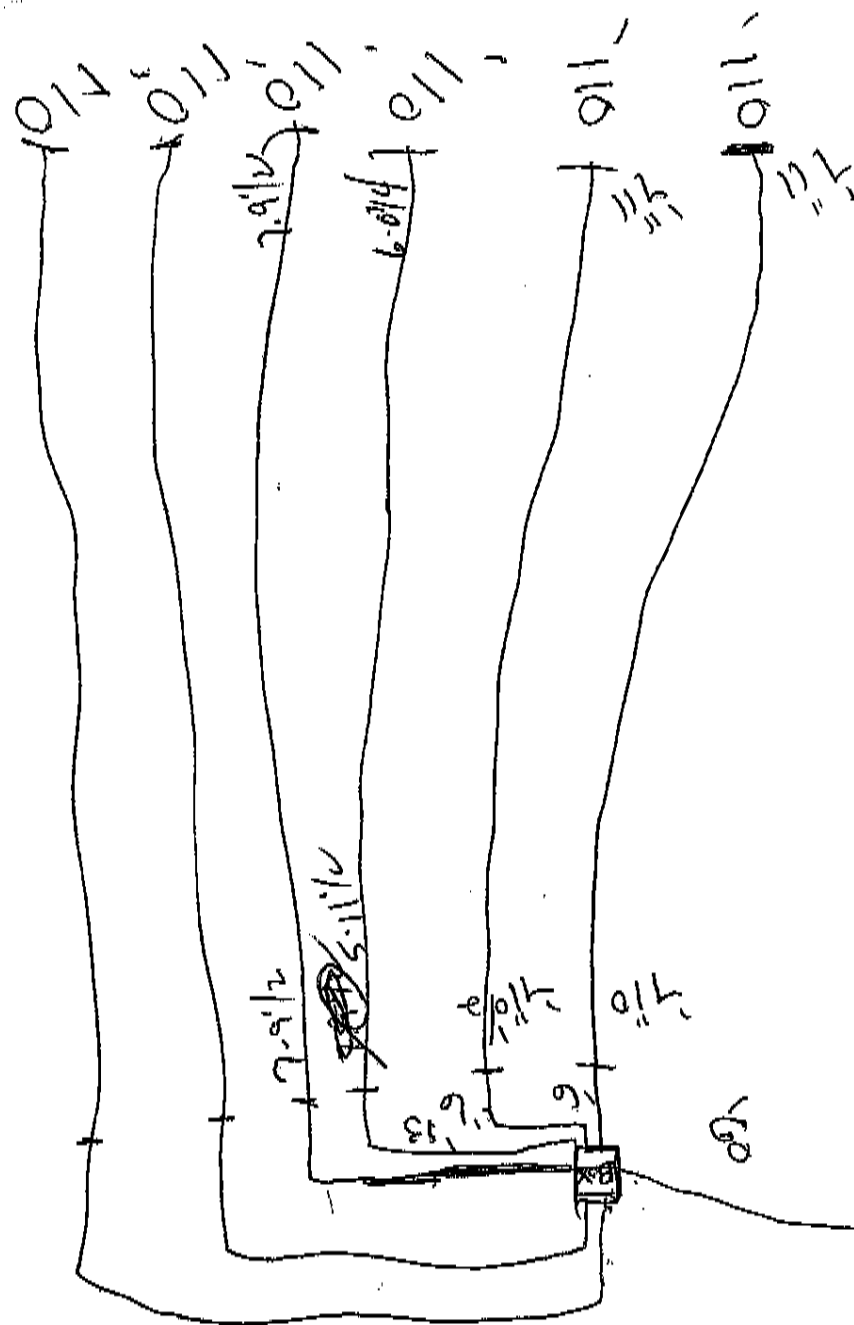

Monday
late apt.

