

SS-177 7/98

STATE OF WEST VIRGINIA

INSPECTION TO BE
PRINTED OR TYPED

HEALTH DEPARTMENT

Permit No.: ST-14-00-169

Tax Map: _____ Parcel: _____

County Road: _____

ON-SITE SEWAGE DISPOSAL SYSTEM

INSPECTION FORM

County: Wm Pitt/RoName of Owner: Boris Karamanov Installer: R. MillerAddress: 2402 Church Hill Road Silver Spring, Md 20902Property Location: Redstone Mountain Lot 602Type of Facility: House Facility is: New () Existing () Lot Size: 50 Sq. Ft./AcresDesign Loading in gpd/No. Bedrooms: 3 BR Source of Water Supply: well

SEWAGE TANK COMPONENT

Capacity in Gallons: 1600 Material: Concrete Manufacturer: WinchocorDistances (in feet) of Tank to: Dwelling: 24' Private () / Public () Water Source: 140' Property Line: 50'

ON-SITE DISPOSAL SYSTEM

Class I Systems: Standard Soil Absorption Trenches () or Bed () Gravelless Pipe (), Diameter: _____ Inches
Chamber Soil Absorption Trenches () or Bed ()Class II Systems: Pumped/Dosed Soil Absorption Trenches () or Bed () Evapotranspiration Trenches () or Bed ()
Shallow Soil Absorption Trenches () or Bed () Other: _____

No. of Lines: _____ Length (in feet) of Each: _____

Width of Trenches: _____ Inches/feet Depth to Bottom of Field: _____ Inches

If Bed, Dimensions (in Feet): 30 X 50 If Chamber System, Name: _____ No. of Units: _____Approved and Adequate Materials Used? Yes () No () Size Equates to: 1500 Square Feet of Standard Gravel FieldDistances (in feet) of System to: Dwelling: 44' Private () / Public () Water Source: 164' Property Line: 50'

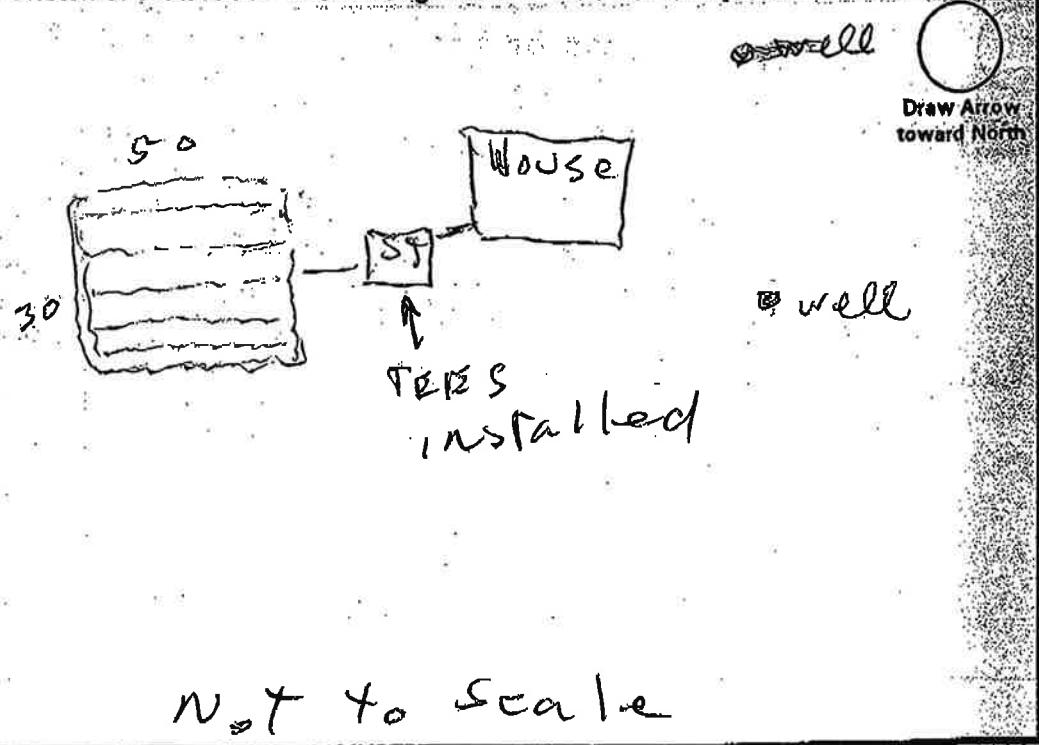
marks: _____

An inspection indicates that the sewage disposal system described above **DOES MEET ()**, **DOES NOT MEET ()**, **CANNOT BE DETERMINED TO MEET ()** the minimum standards established by the West Virginia Bureau of Public Health.

To correct a health hazard, modifications to existing systems may be done to improve part of a system. Such modifications may not be able to be designated as a **does meet** system since inadequate information is known.

Although many factors contribute to the successful functioning of a sewage disposal system, this office recommends water conservation and maintaining an even usage of water throughout the week.

Sketch of Installation with Triangulation or Distance to Specific Landmarks:

Visit Date(s): 11-5-99, 11-17-99Final Inspection Date: 11-17-99Sanitarian: [Signature]

WV STATE DEPARTMENT OF HEALTH
Office of Environmental Health Services
ENVIRONMENTAL ENGINEERING DIVISION

SW258

Rec'd 8-20-99

Redstone East Lot 27.

WELL COMPLETION REPORT

Date(s) 8/17/99 County Hampshire Permit #: DW-14-00-17
 Town: Bohrertown Area Name/Location Redstone East Trail
 Well Owner: Borris Karamanov Address: P. O. Box 530
Upperville, VA 20185
 Telephone Number: 540-592-3780
 Well Driller: Jeffrey G. Miller Address: P. O. Box 412
Shanks, WV 26761
 Telephone Number: 496-9972

WELL LOG

DEPTH IN FEET	FORMATIONS: KIND, THICKNESS, AND IF WATER BEARING	REMARKS: Pressure Grouted
0-25	Brown Shale	Type of Well: <u>D/W</u> Drilling Method: <u>Air Percussion</u>
25-35	Red Shale	Well Diameter: <u>6 1/4"</u> Casing O.D.: <u>6 5/8"</u>
35-75	Red Sandstone (Cons)	Well Depth: <u>360</u> Date Completed: <u>8/13/99</u>
75-93	Lt. Blue Sandstone	CASING: Length <u>50</u> Feet Height above ground <u>1</u> Feet
93-167	Red Sandstone	☒ Steel ☐ Plastic ☐ Cast Iron
167-172	Lt. Blue Sandstone	Other _____ Type _____
172-323	Red Sandstone	SCREEN
323-360	Lt. Blue Sandstone	☒ None Installed
		Type _____ Diameter _____
		Slot/Gauge _____ Length _____
		Set Between _____ Ft. and _____ Ft.

PUMPING OR BAILING TEST

DETAILS	#1	#2	#3
Static Water Level (Ft. Below Grade)	71		
Pumping Rate (GPM)	10		
Pumping Level (Ft. Below Grade)	358		
Duration of Test (In Hours)	2		
Recovery Time to Static Level (In Hours)	8		

WELL HEAD

Pitless Adapter: Type, Make, Etc. _____
 Well Cap: Type, Make, Etc. _____
 Well Seal: Type, Make, Etc. _____
 Well Platform:
 Length _____ Width _____ Thickness _____
 Grouting: ☒ Yes ☐ No
 All Public Water Supplies must be grouted.

I hereby certify that this well was drilled and constructed under my supervision, in compliance with all requirements of the referenced permit, and that this record is true to the best of my knowledge and belief.

Jeffrey G. Miller 255
 Name _____ Certification No. _____
Miller Bros. Drilling
 Registered Business Name _____
 Signed _____ Date 8/17/99