

8469

GASTON COUNTY SEPTIC TANK INSPECTION RECORD ENVIRONMENTAL HEALTH DIVISION

S.T. ID # 8059

CODE/SUB 18

DATE: 11-7-90

Owner Name: Taylor Dr. James
Address: 1023 Robinson Rd.
City/St.: Gastonia
Zip: _____
Prev. Owner: _____

No. of Tanks: 1 Cap: 1500
No. of Tanks: 1 Cap: 1500
Type Sewer System: Con. (Sand, Pump)
Site Class: P.S. (S, PS, N)
WATER SYSTEM #: _____

SEPTIC TANK I.D. #: 8059
Date Installed: 11-7-90
Improve. Permit #: 8901 (8961)
Type Dwelling: House
No. of Bedrooms: 4
Users/Tot. People: 8
Garbage Disposal: N (Y/N)
Basement: N Plumbing: N (Y/N)
Est. Daily Flow: 420

Sys. Name: _____
Loc/SubDiv.: Robinson Highway 1/2 mile
from Union Rd. going toward

Type Well: C Lot # _____ Block # _____
Lot Area: _____
Contractor: M. Ratliff PH # 922-4624
Precast Contractor: L. McSwain & CC auto flooring

No. of Trenches: 4 Sq. Ft.: 1200 Lin. Ft.: 400 Width: 36" Max. Depth: 36"
[Repair] # Trenches: _____ Sq. Ft.: _____ Lin. Ft.: _____ Width: _____ Max. Depth: _____
Sep. Trench/Wash: _____ Sq. Ft.: _____ Lin. Ft.: _____ Width: _____ Max. Depth: _____

Depth of Stone: 12"

Other Materials: _____

Tax Book #: 10

Tax Map #: 092

Tax Parcel #: 8.01

Code #: 18

X Coordinates: _____

Y Coordinates: _____

(A) Public Comm.

(B) Public Non-Comm.

(C) Priv.

(D) Comm.


(E) Municipal

IP Issued By: James O. McEntire

Inspected By: H. H. H. H.

59
59

LOCATION

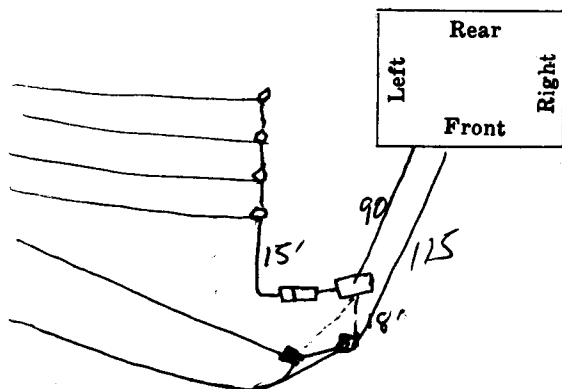

HOUSE SEWER: 25 feet from right, left, front, rear corner.

SEPTIC TANK: Front, rear right side, left side of building.

Perpendicular, parallel, angle 90 feet from building.

DISTRIBUTION BOX: 15 feet from end, side, corner of septic tank.

NITRIFICATION FIELD OR FILTER: 90 feet from building at nearest point.

WELL (IF ANY): 100' feet from septic tank and 100' feet from disposal field.

SOIL APPEARANCE: Suitable, Provisionally suitable

REMARKS: _____
