


Site Drawing

By Martin H. Brewer, Hill Country Septic Service, License #0010374

Compass
North

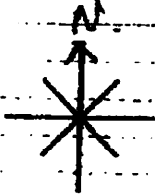

Ronnie Brighman

Hill Line Dr.


Hills & Dales Sub.

Ingram, TX 78025

#007-235

House < 1500 ft² 2 bdrn.
180 GPD 11% grade in sprinkled area

As built
Joe Barrett

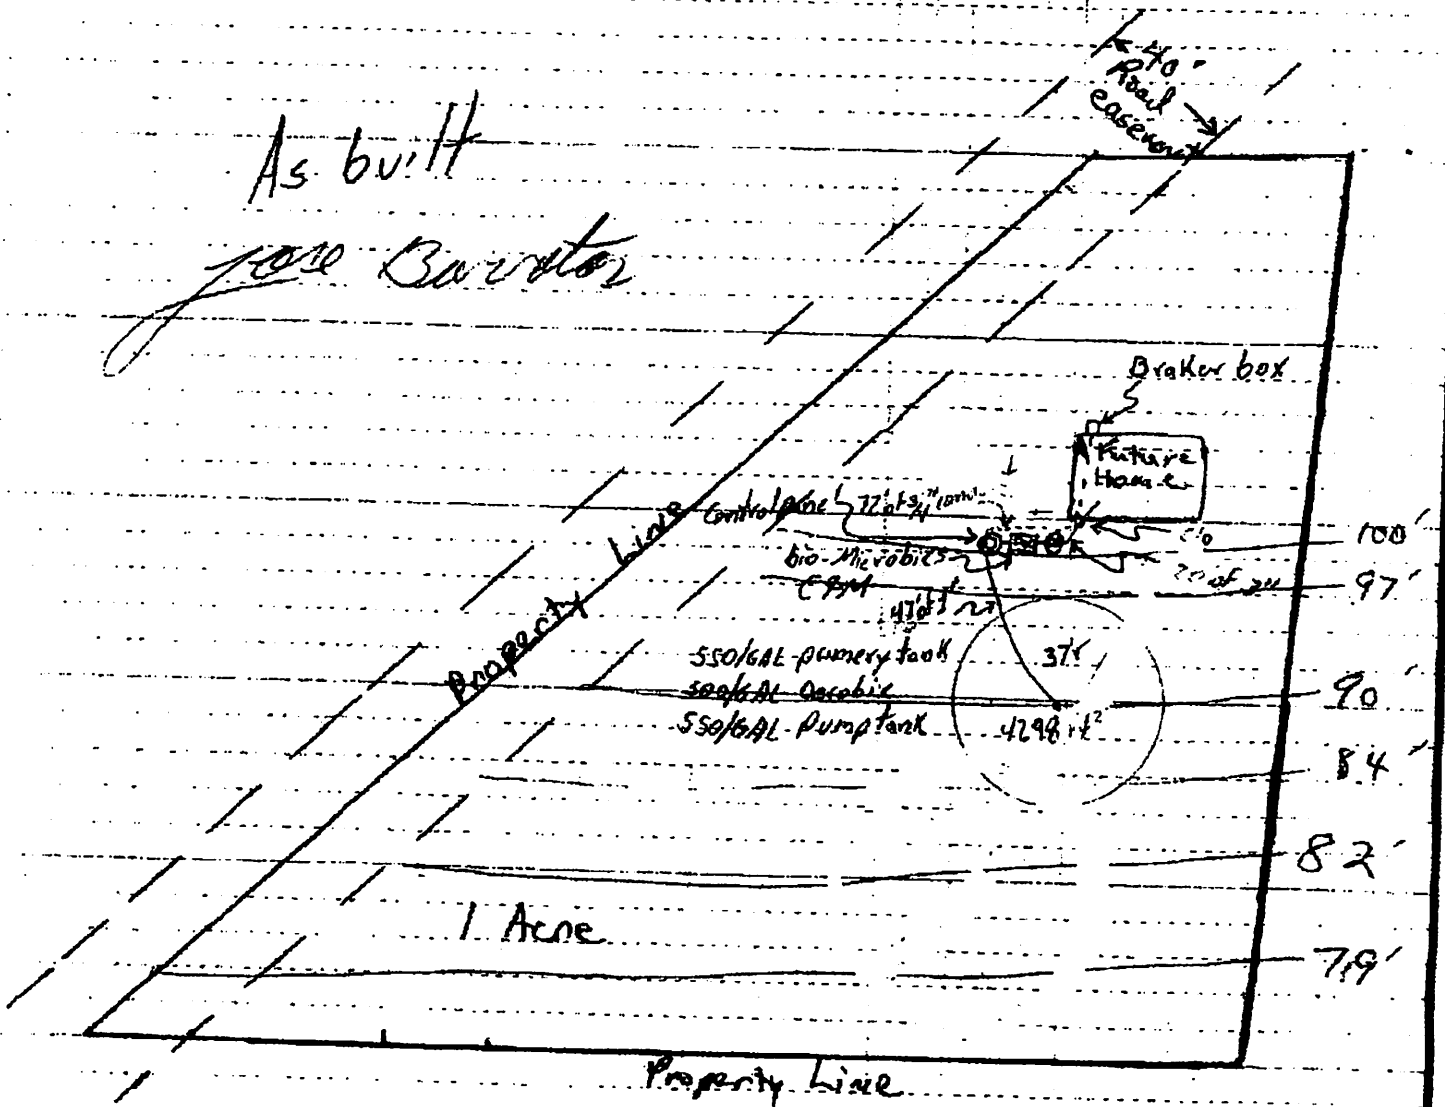

Scale: 1 inch = 50 feet