

Office of Environmental Health Services
ENVIRONMENTAL ENGINEERING DIVISION

WELL COMPLETION REPORT

Well(s) 3-21-95 County Hampshire Permit #: DW-14-1-95-134
 Town: Yellow Springs Area Name/Location MPK Rd
 Well Owner: Lynn + William Goleman Address: P.O. Box 127
 Telephone Number: 703-347-3939 Yellow Springs, WV
 Well Driller: Randal C. Miller Address: Rt #1 Box 186
 Telephone Number: 304-738-3266 Ridgeley, WV 26753

WELL LOG

DEPTH IN FEET	FORMATIONS: KIND, THICKNESS, AND IF WATER BEARING	REMARKS:
0-73'	Yellow Sand (Unconsolidated)	Pressure Grouted
73'	Blue Sandstone (Bedrock)	Type of Well: <u>DW</u> Drilling Method: <u>Air Rotary Hammer</u>
83'	Blue Sandstone (Consolidated)	Well Diameter: <u>6 5/8"</u> Casing O.D.: <u>6 5/8"</u>
	Set Casing	Well Depth: <u>255'</u> Date Completed: <u>3-21-95</u>
155'	Blue Sandstone (Water 4 gpm)	CASING: Length <u>84'</u> Feet Height above ground <u>1'</u> Feet
220'	Blue Sandstone (Water 8 gpm)	☒ Steel ☐ Plastic ☐ Cast Iron
255'	Blue Sandstone (Consolidated)	Other _____ Type _____
	Stopped Drilling	
		SCREEN
		☒ None Installed
		Type _____ Diameter _____
		Slot/Gauge _____ Length _____
		Set Between _____ Ft. and _____ Ft.

PUMPING OR BAILING TEST

DETAILS	#1	#2	#3
Static Water Level (Ft. Below Grade)	<u>70</u>		
Pumping Rate (GPM)	<u>12</u>		
Pumping Level (Ft Below Grade)	<u>215</u>		
Duration of Test (In Hours)	<u>2</u>		
Recovery Time to Static Level (In Hours)	<u>2</u>		

WELL HEAD

Pitless Adapter: Type, Make, Etc. _____
 Well Cap: Type, Make, Etc. Roger-Conduit Type
 Well Seal: Type, Make, Etc. _____
 Well Platform: _____
 Length _____ Width _____ Thickness _____
 Grouting: Pressure ☒ Yes ☐ No
 All Public Water Supplies must be grouted.

I hereby certify that this well was drilled and constructed under my supervision, in compliance with all requirements of the referenced permit, and that this record is true to the best of my knowledge and belief.

Randal C. Miller 432
 Name _____ Certification No. _____
Miller Bros Drilling
 Registered Business Name _____
Randal C. Miller 3-21-95
 Signed _____ Date _____

SS-177.

Revised 1-71

WEST VIRGINIA
SEPTIC TANK INSPECTION FORM

V-7' Septic

Hampshire Co. Health Department Installation Permit No. ST-14-95-449
Name of Owner William & Lynn Golemon
Address P.O. Box 127 Yellow Springs, WV 268105
Property Address Milk Rd Yellow Springs

DESCRIPTION & NUMBER OF UNITS SERVED

Type Facility Served house No. Water Closets
Lot Size 10 acres ~~sq. ft.~~ Area suitable for sewage disposal installation sq. ft.
Source of Water Supply well No. Lavatories
No. Bedrooms 3 No. Showers or Tubs No. Baths
No. Garbage Grinders No. Automatic Washers 1

SEPTIC TANK

Material concrete Length x Width x Depth = cubic feetLiquid Depth ft. Liquid Capacity 1000 gal.Distance to: Dwelling 45' Water Supply 15' Nearest Property Line 300 yds

SOIL ABSORPTION SYSTEM

Type Drain Line Material gravelless pipe Trench Width 24 InchesTrench Depth 24 Inches Total Absorption area in Trench Bottom 1620 sq. ft.Diameter of Drain Line 10 Inches Type Filter Media No. of Drain Lines 10 Depth Filter Media Under Drain Line InchesLength of Each Line 90, 90, 90, 90 ^{90' 90'} ft. Depth Filter Media Over Drain Line inDistance of Disposal Field to: (a) Dwelling 132'(b) Water Supply 149' (c) Nearest Property Line 300 yds

An inspection of the septic tank system described herein disclosed that said system (MEETS, DOES NOT MEET) the minimum standards established by the West Virginia State Department of Health.

Date

Sanitarian

SKETCH OF SYSTEM TO BE DRAWN ON BACK


Note: Copy of this inspection report must be given to owner and the original filed in the Health Department files. PERMANENT RECORD - DO NOT DESTROY.

pg 2 of 2

MILK ROAD

DRIVEWAY

DIVERSION 18 TON GRAVEL

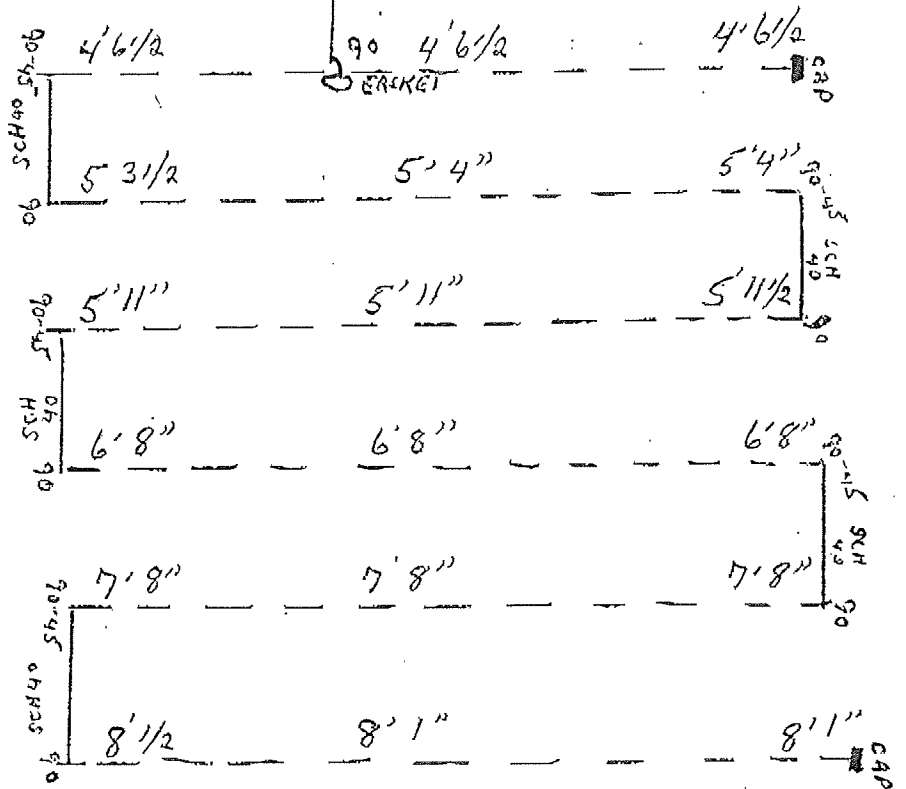

SCH 40

S1

122"

DIVERSION

CLEAN OUT