

Janet Beam

From: TR Drilling [trdrilling@boernewireless.net]
Sent: Thursday, August 16, 2007 11:09 AM
To: Jan Beam
Subject: Emailing: Well Report Tracking #119902 DW5822

DW5822

STATE OF TEXAS WELL REPORT for Tracking #119902

Owner:	Dean Walt Miller	Owner Well #:	DW5822
Address:	9215 Camborne San Antonio, TX 78250	Grid #:	68-02-4
Well Location:	392 Kendall Jackson Comfort, TX 78013	Latitude:	29° 56' 52" N
Well County:	Kendall	Longitude:	098° 50' 19" W
Elevation:	1561 ft.	GPS Brand Used:	Garmin Geko 101
Type of Work:	New Well	Proposed Use:	Domestic

Drilling Date: Started: 7/24/2007
 Completed: 7/26/2007 ✓

Diameter of Hole: Diameter: 8 3/4 in From Surface To 20 ft
 Diameter: 8 In From 20 ft To 450 ft

Drilling Method: Air Rotary

Borehole Completion: Open Hole

Annular Seal Data: 1st Interval: From 0 ft to 250 ft with 2.75ydCmentGrot (#sacks and material)
 2nd Interval: No Data
 3rd Interval: No Data
 Method Used: Gravity
 Cemented By: TR Drilling & Service LLC
 Distance to Septic Field or other Concentrated Contamination: 150 ft
 Distance to Property Line: No Data
 Method of Verification: estimated
 Approved by Variance: No Data

Surface Completion: Surface Slab Installed

Water Level: Static level: 183 ft. below land surface on 7/25/2007
 Artesian flow: No Data

Packers: 2 @ 250'

Plugging Info: Casing or Cement/Bentonite left in well: No Data

Type Of Pump: Submersible
 Depth to pump bowl: 400 ft

Well Tests: Estimated

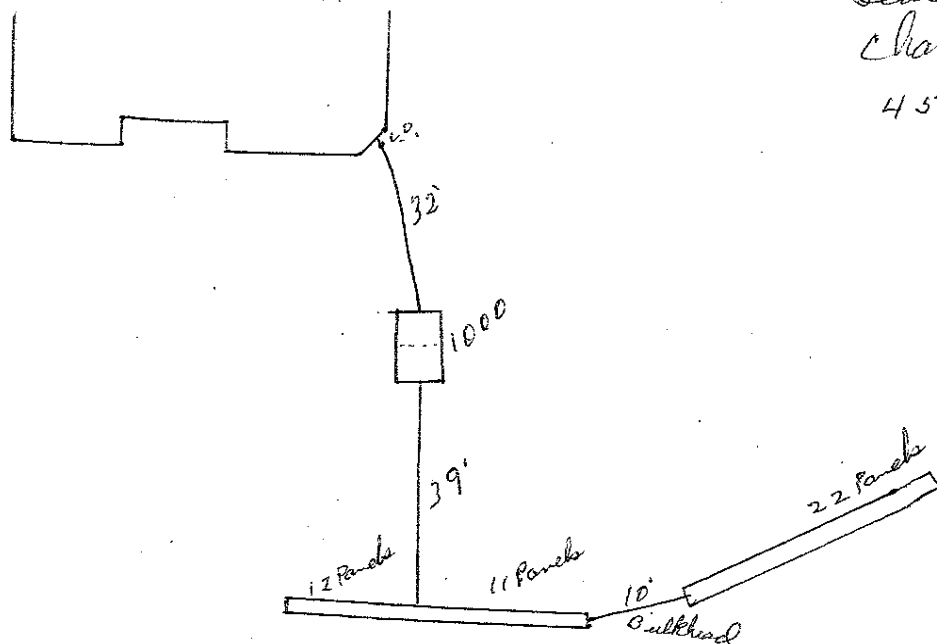
8/16/2007

08/16/2007 THU 11:47

【JOB NO. 5505】

0001

KENDALL COUNTY
 Department of
DEVELOPMENT MANAGEMENT
 201 East San Antonio Street, Suite 100
 Boerne, Texas 78006
 Telephone: (830) 249-9343 Ext. 201

FILE # S 7925**SEPTIC FORM**Private Sewage Facility (Licensed) in Kendall County, Texas**APPLICANT INFORMATION:**Property Owner Walt Miller Installer/Lic.# Jimmy Davis PL 21078
 (Licensee)Subdivision or Location 391 ET 4/18/09
392 Kendall JacksonNo. Bedrooms 3 or Sq. Ft. of House 2300 of Gal/Day 240Application rate for surface irrigation _____ loading rate based on soil type .2Class No. III Trench Req. Sq. Ft. 1200 Aerobic Type _____Gallon Capacity Req. for Concrete Septic Tank 1000 2 compartmentInstalled: Length 180 Width _____
 Sq. Ft. 900 Bed _____ Trench _____Remarks: _____
 (Sketch of Approximate Distances, Not To Scale.)Leaching
Chambers
45 Panels

The County of Kendall, The Texas Department of Health, or their agents or designees, makes no representation that facilities herein licensed will provide satisfactory service to the premises served. It will be the licensee's responsibility to make any changes or modifications which operating experience may show to be necessary in order for these facilities to provide satisfactory service. Septic distances meet minimum Texas Department of Health separation distances in most instances. Some renovations may be less if repaired or replaced in the same general area as the pre-existing system being renovated.

PERMIT (LICENSE) GRANTED AND APPROVED THIS DATE 2-6-08
Sanford J. Jennings
 Designated Representative