



GUARANTEES OR CERTIFICATIONS ARE NOT TRANSFERABLE. UNDERGROUND UTILITIES
 EASEMENTS NOT SHOWN AND UTILITY POLE LOCATIONS ARE NOT GUARANTEED.
 THE OFFSET DIMENSION SHOWN HEREON FROM THE STRUCTURES TO THE PROPERTY LINES
 ARE FOR SPECIFIC PURPOSE AND USE, THEREFORE ARE NOT INTENDED TO GUIDE THE
 ERECTION OF FENCES, RETAINING WALLS, POOLS, PATIOS, PLANTING AREAS,
 ADDITION TO BUILDINGS AND OTHER CONSTRUCTION. THE EXISTENCE OF RIGHT
 OF WAYS, WETLANDS AND/OR EASEMENTS OF RECORD, IF ANY, NOT SHOWN
 ARE NOT GUARANTEED.
 UNAUTHORIZED ALTERATION OR ADDITION TO THIS SURVEY IS A VIOLATION OF
 SECTION 7209 OF THE NEW YORK STATE EDUCATION LAW. COPIES OF THIS SURVEY MAP
 NOT BEARING THE LAND SURVEYOR'S SIGNATURE AND RED INK OR EMBOSSED SEAL SHALL
 NOT BE CONSIDERED A TRUE VALID COPY.
 ALL LOCATIONS OF AND DISTANCES TO WELLS AND CESSPOOLS ARE BY LOCATIONS
 FROM HOMEOWNERS, FIELD OBSERVATIONS AND/OR INFORMATION OBTAINED FROM
 OTHERS. SINCE MOST ARE NOT VISIBLE THESE LOCATIONS AND DIMENSIONS CANNOT
 BE CERTIFIED.

SURVEY OF DESCRIBED PROPERTY SITUATED AT KINGS PARK, TOWN OF SMITHTOWN SUFFOLK COUNTY, NEW YORK

S.C.T.M. NO. 800-42-1-28
 AREA = 169,575 SQ. FT./3.89 ACRES
 ELEVATIONS NAVD 1988 DATUM

OLD COMMACK ROAD

OLD NORTHPORT ROAD

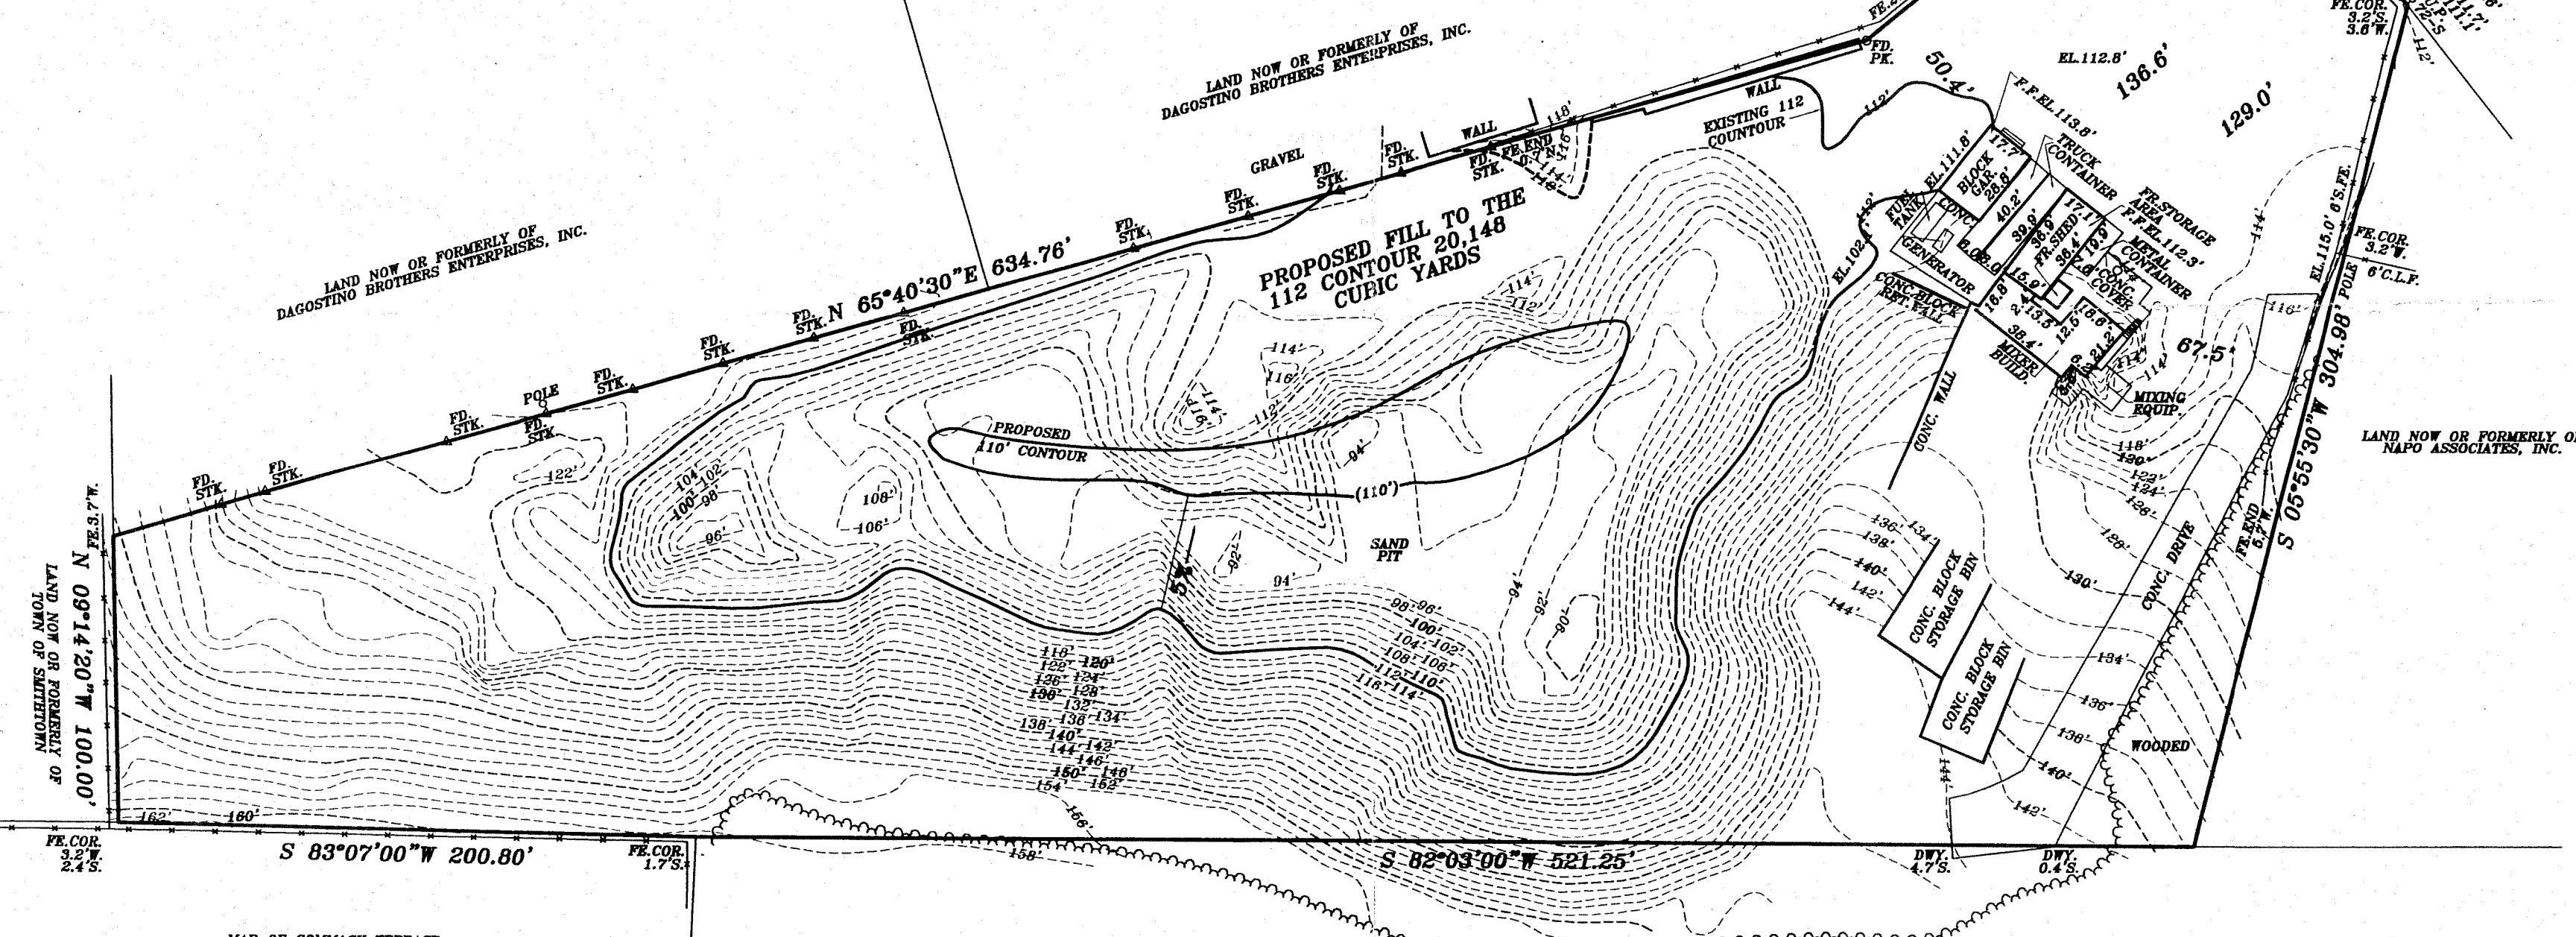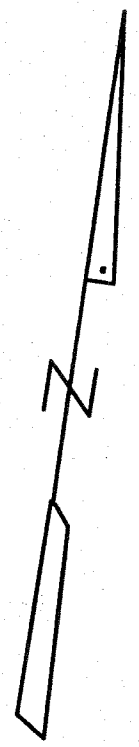

MAP OF COMMACK TERRACE
 F: 01/24/1984 MAP NO. 7695

MAP OF COUNTRY ESTATES AT COMMACK,
 SECTION 5
 F: 06/05/1995 MAP NO. 9673

PAT T. SECCAFICO
 PROFESSIONAL LAND SURVEYOR, P.C.
 - SUCCESSOR TO -
 DONALD TASE, L.S.
 RICHARD WILHELM AND ASSOCIATES
 NORTHSTAR SURVEYING, P.C.
 PAUL T. CANALIZO, L.S., ROBERT A. KART, L.S.
 GOOD GROUND SURVEYORS, P.C.

328A Main Street
 Center Moriches, NY 11934
 Phone: (631) 878-0120
 Fax: (631) 878-7190

Hampton Atrium Unit D-4
 186 W. Montauk Highway
 Hampton Bays, NY 11946
 Phone: (631) 728-5330
 Fax: (631) 728-6707

N.Y.S. LIC. NO. 049287
 COPYRIGHT - 2011 PAT T. SECCAFICO P.L.S., P.C.