
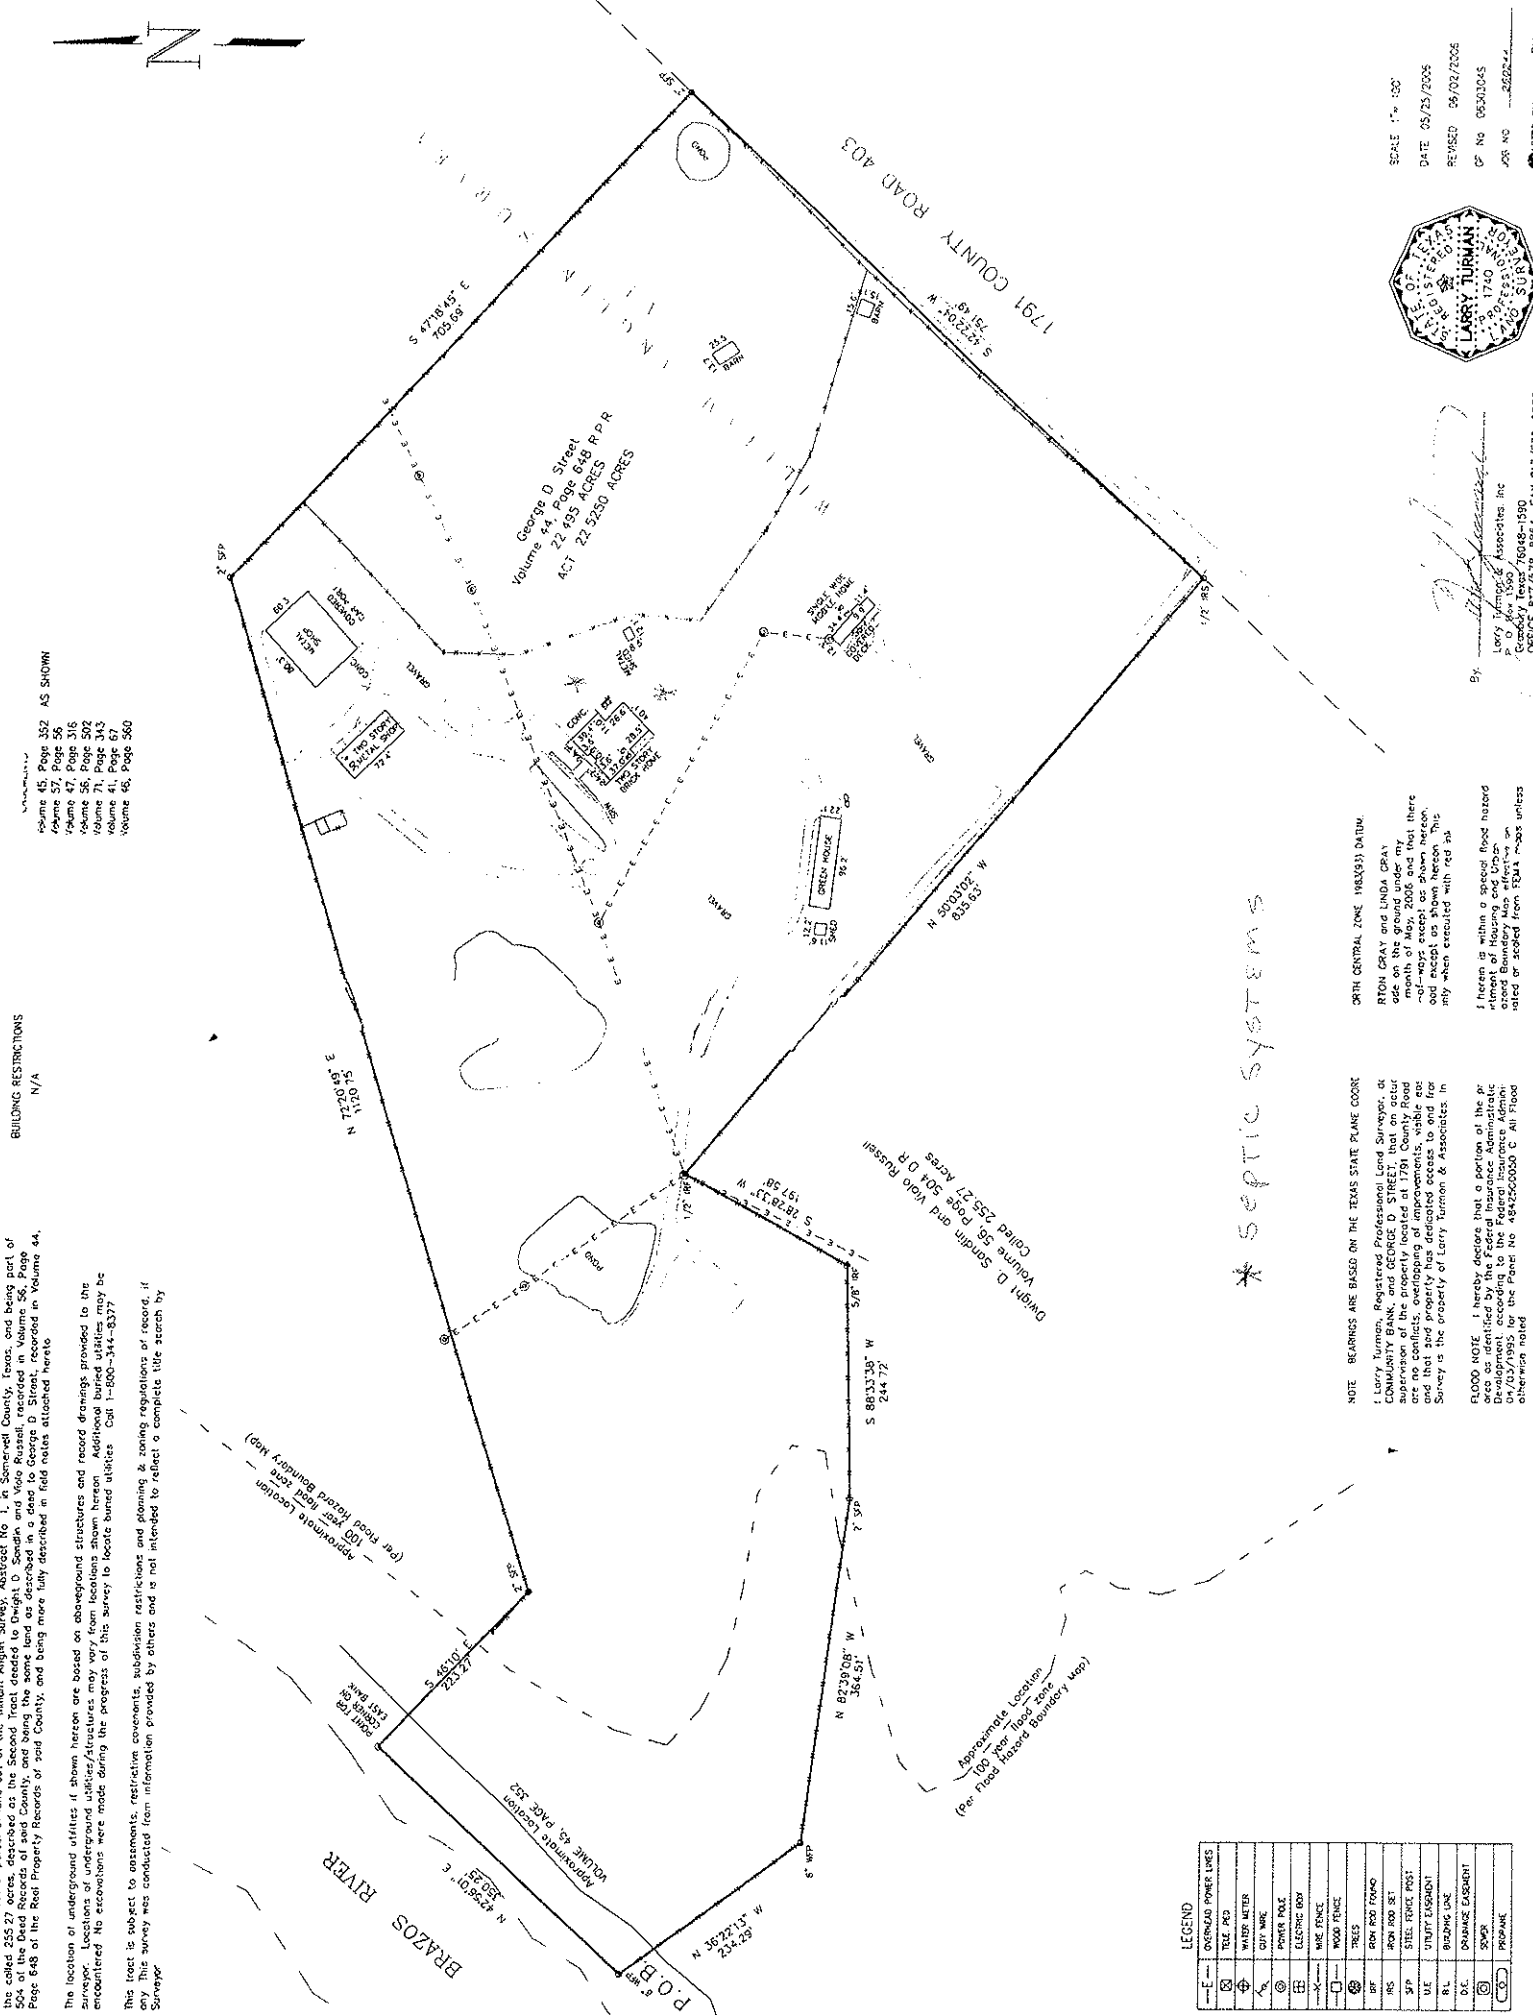


the location of underground utilities if shown hereon are based on aboveground structures and record drawings provided to the surveyor. Locations of underground utilities/structures may vary from locations shown hereon. Surveyors are not responsible for buried utilities encountered. No excavations were made during the progress of this survey to locate buried utilities. Call 1-800-344-0377.


This tract is subject to easements, restrictive covenants, subdivision restrictions and planning & zoning regulations of record, if any. The survey was conducted from information provided by others and is not intended to reflect a complete title search by Surveyor.

BUILDING RESTRICTIONS
N/A

Volume 45, Page 352 AS SHOWN
Volume 57, Page 56
Volume 47, Page 316
Volume 56, Page 502
Volume 71, Page 343
Volume 45, Page 57
Volume 46, Page 560

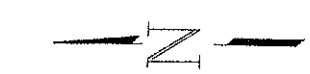

SCALE 1" = 150'
DATE 05/25/2006
REVISED 06/02/2006
OF NO 06303045
JOB NO 222222
DRAWN BY

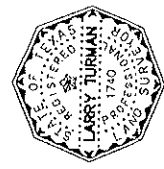

By: *[Signature]*
Larry Turman, Surveyor
P.O. Box 1500, Pecos, NM 87654
OFFICE 817/578-8854 FAX 817/579-5850

NOTE: BEARINGS ARE BASED ON THE TEXAS STATE PLANE COORDINATE SYSTEM.

1. Larry Turman, Registered Professional Land Surveyor, at the request of the owner, has conducted a survey of the property located at 1791 County Road 403, Pecos, New Mexico, and has found that there are no conflicts, overlapping of improvements, visible easements, or other matters of record which would affect the survey and that said property has dedicated access to and from the Brazos River.

FLOOD NOTE: I hereby declare that a portion of the property shown hereon is within a special flood hazard area of the United States as shown on Flood Insurance Rate Maps (FIRM) No. 48425C0000 C All Flood Insurance rates or scaled from FEMA maps unless otherwise noted.

*SEPTIC SYSTEMS