

Revised 1-71

WEST VIRGINIA
SEPTIC TANK INSPECTION FORM

Hammerhead County Health Department Installation Permit No. ST-14-25-158
 Name of Owner Victor Slemosky
 Address 6910 Snackle Pl., Bunk, VA 22015
 Property Address High Mtn. Orchards Lot #17

DESCRIPTION & NUMBER OF UNITS SERVED

Type Facility Served residence No. Water Closets
 Lot Size 4 1/2 acres sq. ft. Area suitable for sewage disposal installation sq. ft.
 Source of Water Supply cistern No. Lavatories
 No. Bedrooms 3 No. Showers or Tubs No. Baths
 No. Garbage Grinders No. Automatic Washers

SEPTIC TANK

Material concrete Length x Width x Depth = cubic feet
 Liquid Depth ft. Liquid Capacity 1000 gal.
 Distance to: Dwelling 20' Water Supply 100' Nearest Property Line 110'

SOIL ABSORPTION SYSTEM

Type Drain Line Material perforated Trench Width 36 Inches
 Trench Depth 24-26 Inches Total Absorption area in Trench Bottom 900 sq. ft.
 Diameter of Drain Line 10 Inches Type Filter Media
 No. of Drain Lines 4 Depth Filter Media Under Drain Line Inches
 Length of Each Line 60, 80, 80, 80 ft. Depth Filter Media Over Drain Line in
 Distance of Disposal Field to: (a) Dwelling 40'
 (b) Water Supply 100' + (c) Nearest Property Line 25'

An inspection of the septic tank system described herein disclosed that said system (MEETS) DOES NOT MEET the minimum standards established by the West Virginia State Department of Health.


Date

10-28-94

Sanitarian

SKETCH OF SYSTEM TO BE DRAWN ON BACK

Note: Copy of this inspection report must be given to owner and the original filed in the Health Department files. PERMANENT RECORD - DO NOT DESTROY.

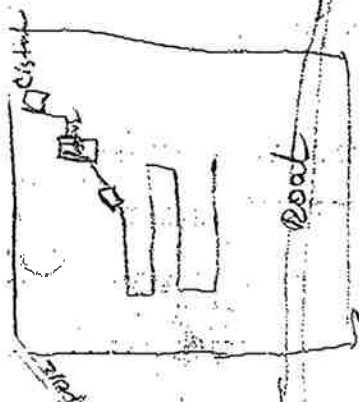

High Mtn Richards
Lot #17

Cross overs are close top of Grand,
any excavation. In cross over areas will
will hamper or harm the service of
this system.

- tank to house 20'
- top tank 3"
- top outlet 13"
- top inlet 10"
- tank to first line - 11'
- top 1st line 26' 1/2" and 26' 1/2"
- top 1st crossover 23"

1st line to 2nd line - 11' at C.O.

top 2nd line - 64' - 64 1/2"
top crossover 62 1/2"

septic tank to 2nd line - Down Hill 23'

septic tank to 3rd line - 46'


septic tank to 4th line - 62'

top of 3rd ditch inlet 10" top of crossover 6"

top of 4th line - 66"

78" 2nd transit to bottom of 4th ditch.

Elect pole to 1st line - 147'

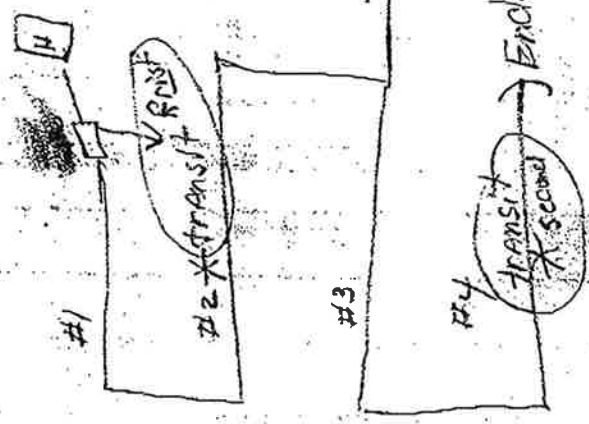

1st tank to bottom
of ditch 17-10" ±

from 2nd transit set.