

REQUEST FOR INDIVIDUAL ON-SITE WATER SUPPLY
AND/OR SEWAGE DISPOSAL SYSTEM EVALUATION

Just S

35
Rev. 5/89

TO BE COMPLETED BY LENDING AGENCY

Lending Agency

Case No.

Roscoe SHURE

Purchaser

Property Owner

P.O. 360

Address

Address

SHANESVILLE, WV 25444

Phone No.

Phone No.

304-492-5302

Detailed Directions for Locating Property: (Be Specific)

Deed # 352 Page 788

Multi-Living Units	Number Bedrooms	Number Baths	Dishwasher	Garbage Disposal	Basement	Dwelling
() Yes (X) No	3	2	(X) Yes () No	() Yes (X) No	() Yes (X) No	() New (X) Existing

TO BE COMPLETED BY HEALTH DEPARTMENT SANITARIAN

WATER SUPPLY

Type: (X) Drilled Well () Dug Well () Cistern () Spring () Other

(X) Yes () No Meets minimum design standards (physical). Date Inspected

() Yes () No Bacteriological water sample collected. Date

Results: () Satisfactory () Unsatisfactory Laboratory Sample No.

SEWAGE DISPOSAL SYSTEM

Sewage system installed under permit? () Yes (X) No Permit No.

Date of original inspection Date dye test conducted () Posit

() Negat.

If sewage disposal system was not installed under permit, complete the following:

System meets minimum design standards

Are you aware of any sewage disposal system problems in the neighborhood?

Is lot size adequate for the system to be modified or a new system installed?

Was house vacant at the time of inspection?

(X) Yes
(X) Yes
(X) Yes
(X) Yes

WATER SUPPLY IS:

() Satisfactory as a water supply
for the subject property.() Not satisfactory as a water supply
for the subject property.

SEWAGE DISPOSAL SYSTEM:

(X) Functioning satisfactorily at
the time of evaluation.() Not functioning satisfactorily at
the time of evaluation.

REMARKS:

Septic system evaluated and determined to be
functioning adequately.

10-6-97

DATE

SANITARIAN

Hampshire County

HEALTH DEPARTMENT

HAMPSHIRE COUNTY HEALTH DEPARTMENT

INSTALLATION PERMIT NO. No Permit Issue

NAME OF OWNER

ROSOE SHUPE

ADDRESS

PO Box 300 Lincolnton WVA 25444

PROPERTY ADDRESS

Deed Book # 352 pg 288DESCRIPTION & NUMBER OF UNITS SERVED

TYPE FACILITY SERVED

HOUSE

LOT SIZE

104

ACRES/SQ. FT.

SOURCE OF WATER SUPPLY

WELL

NO. BEDROOMS

3

NO. GARBAGE GRINDERS

NO. AUTOMATIC WASHERS

SEPTIC TANK

MATERIAL

CDNC

LIQUID CAPACITY

1000

GALLONS

DISTANCE TO:

DWELLING

35'

WATER SUPPLY

100'

NEAREST PROPERTY LINE

500'SOIL ABSORPTION SYSTEM

TYPE DRAIN LINE MATERIAL

2929

DIAMETER OF DRAIN LINE

4"

INCHES

TRENCH WIDTH

36

INCHES

TRENCH DEPTH

24

INCHES

NO. OF DRAIN LINES

3

LENGTH OF EACH LINE

100, 100, 100

, , , FT.

TOTAL ABSORPTION AREA IN TRENCH BOTTOM

900

SQ. FT.

TYPE FILTER MEDIA

STONE

TONAGE

DEPTH FILTER MEDIA UNDER DRAIN LINE

6

INCHES

DEPTH FILTER MEDIA OVER DRAIN LINE

2

INCHES

DISTANCE OF DISPOSAL FIELD TO:

(A) DWELLING

50'

(B) WATER SUPPLY

100' +

(C) NEAREST PROPERTY LINE

500' +

DATE

10 6 97

INSTALLER (SIGNATURE)

Sam Haines


CERTIFICATION NUMBER

5476412SKETCH OF SYSTEM TO BE DRAWN ON BACK
(PLEASE NOTE TRANSIT READINGS)

Roscoe Shupe

104 acres

~~Q~~

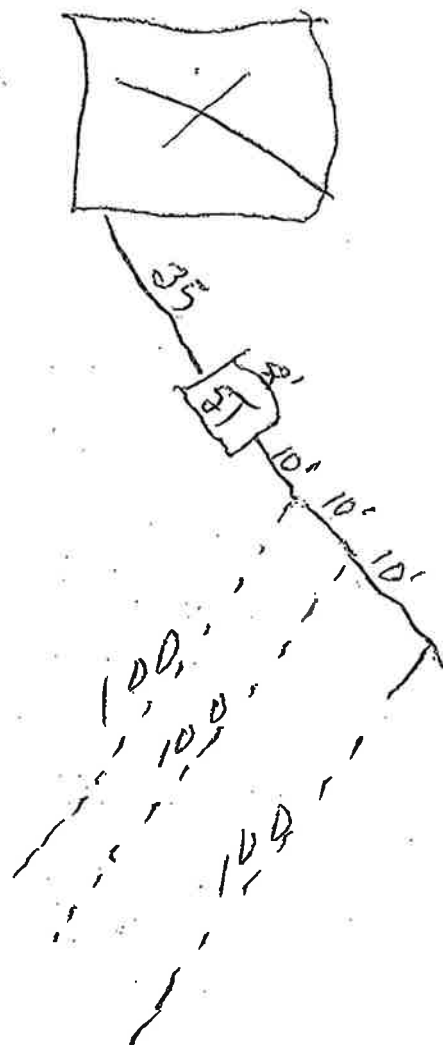

BOTTOM of DITCHES
LEVEL!