

WV Department of Health and Human Resources
Bureau of Public Health
Office of Environmental Health Services
ENVIRONMENTAL ENGINEERING DIVISION

Hampshire

SW258
10/01

DEC 17 2004

Co. Health

WELL COMPLETION REPORT

Date(s) 12-14-04 County Hampshire Permit # DW-14-05-009
Town: THREE Churches Area Name/Location J. Rannells road to sentinel dr. Peach Tree
Well Owner: William Offutt Address: HC 64 Box 2023 Farms Lot
Telephone Number: 822 8451 Romney, WV 26757 IF
Well Driller: Jeffrey Miller Address: P.O. NBox 952
Telephone Number: 822-4092 Rommney, WV 26757

WELL LOG

DEPTH IN FEET	FORMATIONS: KIND, THICKNESS, AND IF WATER BEARING	REMARKS: Pressure Grouted
0-15	Clay	Type of Well: <u>D/W</u> Drilling Method: <u>Air Percussion</u>
15-52	Rede Shale	Well Diameter: <u>6 1/8"</u> Casing O.D.: <u>6 5/8"</u>
52-90	Blue Shale	Well Depth: <u>240</u> Date Completed: <u>12/14/04</u>
90-145	Red Shale	CASING: Length <u>62</u> Feet Height above ground <u>1</u> Feet
145-150	Gray Shale	<input checked="" type="checkbox"/> Steel <input type="checkbox"/> Plastic <input type="checkbox"/> Cast Iron
150-195	Red Shale	Other _____ Type _____
195-230	Blue Shale	SCREEN
230-240	Red Shale	<input type="checkbox"/> None Installed
		Type _____ Diameter _____
		Slot/Gauge _____ Length _____
		Set Between _____ Ft. and _____ Ft.

PUMPING OR BAILING TEST

DETAILS	#1	#2	#3
Static Water Level (Ft. Below Grade)	60		
Pumping Rate (GPM)	75		
Pumping Level (Ft. Below Grade)	225		
Duration of Test (In Hours)	2		
Recovery Time to Static Level (In Hours)	2		

WELL HEAD

Pitless Adapter: Type, Make, Etc. _____
Well Cap: Type, Make, Etc. Royer W/1" Conduit
Well Seal: Type, Make, Etc. _____
Well Platform:
Length _____ Width _____ Thickness _____
Grouting: ☒ Yes ☐ No
All Public Water Supplies must be grouted.

I hereby certify that this well was drilled and constructed under my supervision, in compliance with all requirements of the referenced permit, and that this record is true to the best of my knowledge and belief.

Jeffrey MILLER 255
Name Certification No.
Miller Bros. Drilling
Registered Business Name
Signed Jeffrey Miller Date 12-15-04

SS 177 7/96

INSPECTION TO BE
PRINTED OR TYPED

STATE OF WEST VIRGINIA

HAMPshire Co HEALTH DEPARTMENT
ON-SITE SEWAGE DISPOSAL SYSTEM
INSPECTION FORM

Permit No.: ST-14-05-33

Tax Map: 1 Parcel #: 12

County: Hampshire

County Road: Peachtree Lane Lot 1F

Name of Owner: WILLIAM + ROBIN OFFUTT

Installer: RALPH DAVIS

Address: HC 64 Box 3023

Property Location: ESR RANNEY RD TO SENTINEL (RT) TO LARGE POND

Type of Facility: RESIDENCE Facility is: New (X) Existing () Lot Size: 4,8402 Sq. Ft./Acres

Design Loading in gpd/No. Bedrooms: 3 Source of Water Supply: WELL

SEWAGE TANK COMPONENT

Capacity in Gallons: 1000 Material: CONCRETE Manufacturer:

Distance (in feet) of Tank to: Dwelling: 90 Private (X) Public () Water Source: 100 Property Line: 150

ON-SITE DISPOSAL SYSTEM

Class I Systems: Standard Soil Absorption Trenches () or Bed () Gravelless Pipe (), Diameter: _____ Inches
 Chamber Soil Absorption Trenches (X) or Bed ()
 Class II Systems: Pumped/Dosed Soil Absorption Trenches () or Bed () Evapotranspiration Trenches () or Bed ()
 Shallow Soil Absorption Trenches () or Bed () Other: _____

No of Lines: 3 Length (in feet) of Each: 80, 80, 80
 Width of Trenches: 3 inches/feet Depth to Bottom of Field: 24 inches

If Bed, Dimensions (in Feet): _____ If Chamber System, Name: _____, No. of Units: _____

Approved and Adequate Materials Used? Yes (X) No () Size Equates to 1200 Square Feet of Standard Gravel Field.

Distance (in feet) of System to: Dwelling: 175 Private (X) Public () Water Source: 130 Property Line: 100+


Remarks: _____

An inspection indicates that the sewage disposal system described above ~~DOES MEET~~ **DOES NOT MEET** (), **CANNOT BE DETERMINED TO MEET** () the minimum standards established by the West Virginia Bureau of Public Health.

To correct a health hazard, modifications to existing systems may be done to improve part of a system. Such modifications may not be able to be designated as a does meet system since inadequate information is known.

Although many factors contribute to the successful functioning of a sewage disposal system, this office recommends water conservation and maintaining an even usage of water throughout the week.

Sketch of Installation with Triangulation or Distance to Specific Landmarks:

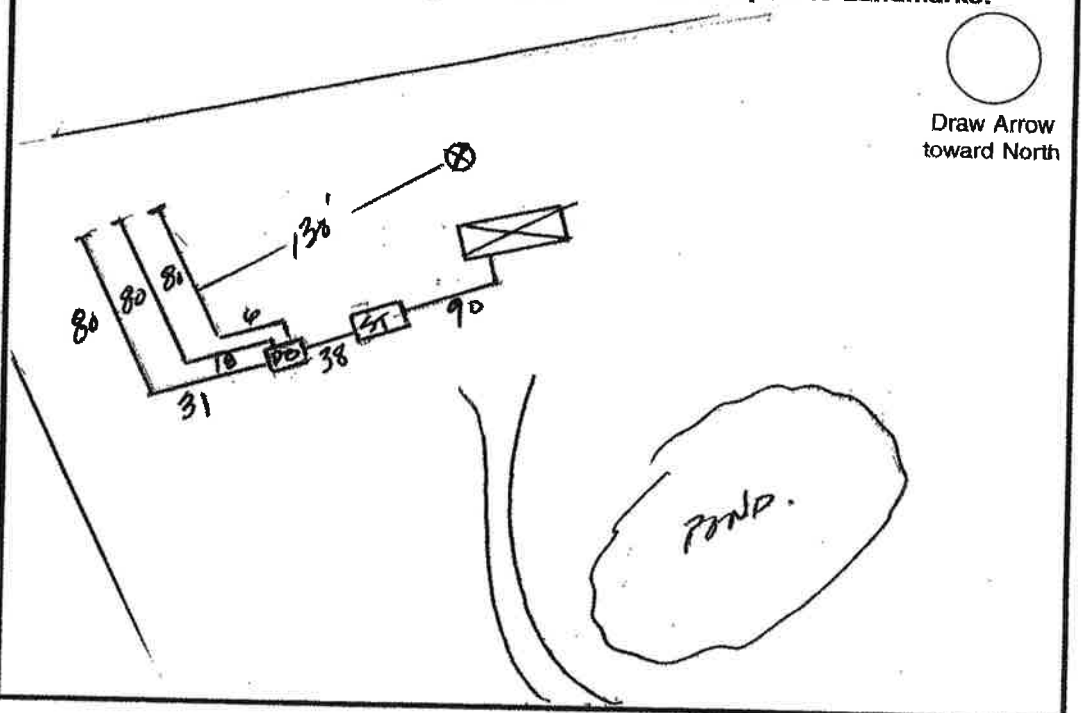

Visit Date(s) 7-2-04
 Final Inspection Date: 12-14-04

Sanitarian: Dakota