




OF NO. 14625-07-01209 NORTH AMERICAN TITLE
ADDRESS: 614 MILLER ROAD
ROSHARON, TEXAS 77583
BORROWER: STEVEN HULSEY

LOT 4, BLOCK 1 PLANTATION LAKES

ACCORDING TO THE MAP OR PLAT THEREOF RECORDED
IN SLIDE NO. 1327/A & B OF THE MAP RECORDS
OF FORT BEND COUNTY, TEXAS

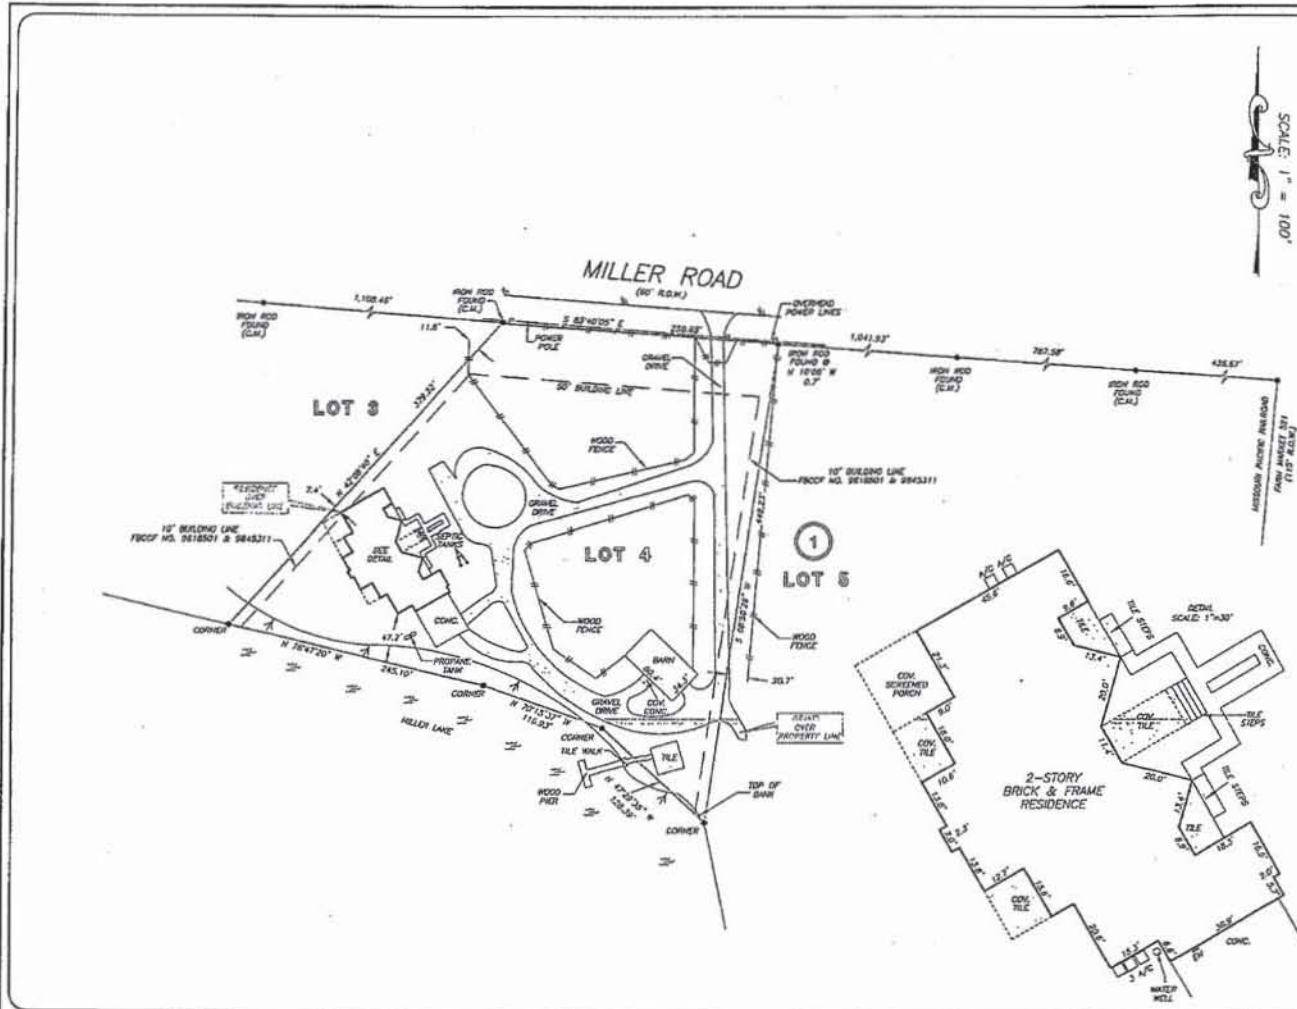

THIS PROPERTY LIES WITHIN THE
100 YEAR FLOOD PLAIN AS PER FIRM
PANEL NO. 48150C 0140 J
MAP REVISION 1-03-1993
ZONE AE
BASED ONLY ON VISUAL EXAMINATION OF MAPS
UNCORRECTED FEMA MAPS PREVENT EXACT
DETERMINATION WITHOUT DETAILED FIELD STUDY.


A SURFACE INVESTIGATION
WAS BEYOND THE SCOPE OF THIS SURVEY

RECORD DRAWING SLIDE NO. 1327/A & B F.B.C.A.R.

DRAWN BY: MAP

I HEREBY CERTIFY THAT THIS SURVEY WAS MADE
ON THE GROUND, THAT THIS PLAT CORRECTLY
REPRESENTS THE FACTS FOUND AT THE
TIME OF SURVEY AND THAT THERE ARE NO
ENCUMBRANCES APPARENT ON THE SURFACE
EXCEPT AS SHOWN HEREON. THIS SURVEY IS
CONSIDERED A FINAL TRANSACTION ONLY AND
ABSTRACTING RECORDED IN THE ABOVE
AUTHORIZED TITLE COMMITMENT WAS RELIED
UPON IN PREPARATION OF THIS SURVEY.

ALLEN B. HUGHES
PROFESSIONAL LAND SURVEYOR
NO. 3891
JOB NO. 07-19893
DECEMBER 3, 2007

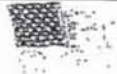

**NORTH
AMERICAN
TITLE
COMPANY**
DENNIS ELIAS
281-550-2540



PRECISION SURVEYORS, INC.

1-800-LANDSURVEY 281-496-1300
1-800-526-3787 FAX 281-456-1867
14025 HOUSTON DRIVE SUITE 8100 HOUSTON, TEXAS 77059