

Tax Code: 06-102-004
System Type: III-g
Zoning: R-40

Union County On-Site Wastewater Disposal System Construction Authorization

Number: 99-644
Date Issued: 9-9-99
Expiration Date: 9-8-2004

This Construction Authorization is issued by the Union County Health Department to construct and install the work hereby described. The construction shall be made in compliance with the N.C. Department of Environment, Health, and Natural Resources Laws and Rules for Sewage Treatment and Disposal Systems, 150 NCAC 10A 1900. Any unauthorized changes to the site or system design shall void this Construction Authorization.

Owner: KENNETH & KATHY TANNEY
Mailing Address: 821 LESTER DAVIS RD. WAXHAW NC 28173
Phone: (h) () 243-2686 (w) () 236-0967 Fax: ()
Location: LESTER DAVIS Subdivision ROAD Phase Section: Lot #
Directions: HWY #84 @ LESTER DAVIS LAST DRIVEWAY ON (L)

Installation for: House: 4 Mobile Home: YES Duplex: YES
Number of Bedrooms: 4 Garbage Disposal (n): YES
Water Supply to be: Individual Well: L Public Water: Other:
Commercial: Industrial: Number of Employees: Seating Capacity of Sanctuary:
Other: (Describe: Church: Kitchen Facilities in Church: (y/n) Day Care (y/n):

New Installation Design Waste Flow: 480 (G.P.D.)

Type of System:
Conventional: Modified Conventional: Pump to Conventional: At-Grade Mound: Other (Describe): Experimental/Innovative: ~~See 232~~ LayPre Treatment: Sand: Bio-Filter:
Design by: Soil Scientist: ~~See 232~~ PAUL J. HARRIS Engineer:

Septic Tank: Capacity: 1600 gal. Compartments: 2 If Site Built: L: W:
Liquid Capacity: gal. Pump Flow: gal/minute @ feet of Total Dynamic Head

Pump Tank: Capacity: gal. Pump Flow: gal/minute @ feet of Total Dynamic Head
Drainfield: Total Length of Lines: 400 Total square feet of disposal area: 200 Line Length: 100' each
Line Width: 36 inches Washed Stone Depth: 24" Maximum depth of lines: 24"
Maximum Grade: 25' 10' Distribution Device: DISTRIBUTED BOX - CONCRETE

System Distance to nearest: Well: 100' Water Line: 10' Foundation: 10' Property Line: 10'

Addition / Repair:

Previous On-Site Wastewater Permit Number:

Repair Components:

Septic Tank: Capacity: gal.
Pump Tank: Capacity: gal.
Pump flow: gal./min. @ TDH
Drainfield: Total length: Individual line length
Line width: Depth of washed stone:
Other:

Comments & Special Conditions:

ANY ALTERATIONS TO THIS LOT MAY VOID THIS PERMIT

I hereby certify that the construction described in this Construction Authorization will be done in accordance with this permit and with the Ordinances, State Laws, Rules and Regulations of the State of North Carolina and the Union County Health Department NOTICE. The issuance of this permit does not relieve the property owner of his responsibility for checking his proposed development with applicable zoning requirements.

Signed: David J. Brown

Permit Prepared by: David J. Brown, R.S.

Date: 9-8-99 Contractor: Norwood

Final Inspection by: Art C. Brown, R.S.

Date: 7-12-00 Certified Operator:

~~Page 110~~ ~~Page 110~~

2106 YAV 222-333 (11)

SHAFT-LOW PLACEMENT +
EFFLUENT DISPOSAL SYSTEM
CONFIGURATION IS TO
BE UTILIZED. RESOURCES BEING


(2) POLYSTYRENE AGGREGATE
BUNDLES WILL BE PLACED
SIDE BY SIDE IN THE
36" WIDE TRENCHES.

(-3) TRENCH DEPTH SHALL BE 24"

(4) NO CONSTRUCTION OF THE SYSTEM WILL TAKE PLACE WHILE THE SOIL IS WET.

(5) PLEASE CONTACT ENVIRONMENT
HEALTH SPECIALIST TO MEET
AT SITE PRIOR TO
INSTALLATION.

(6) DRAWFIELD AREA IS FLAGGED.

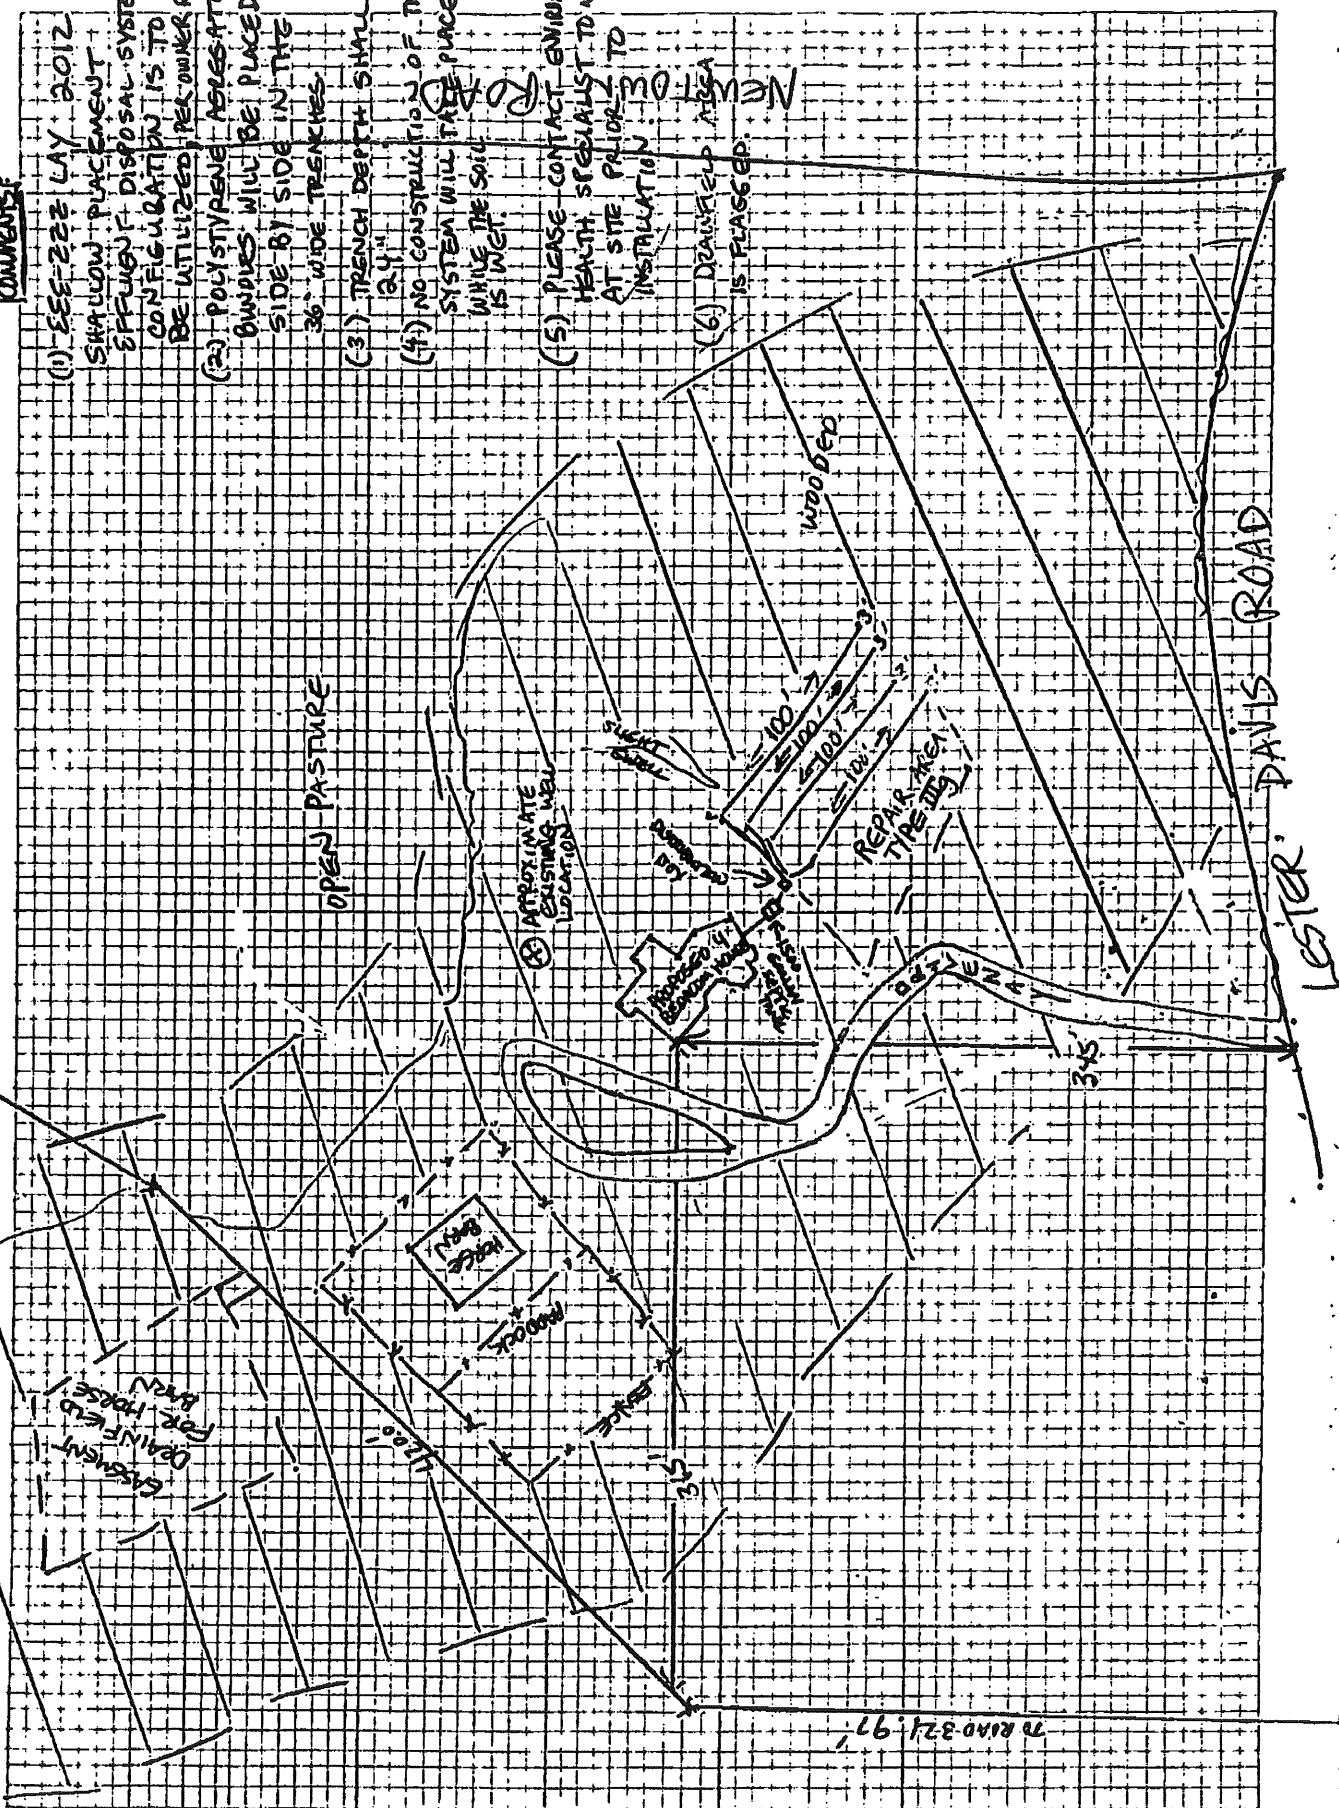

Code 06-102-004

System Type HC Zoning: R-40UNION COUNTY
On-Site Wastewater Disposal System Permit
CONSTRUCTION AUTHORIZATIONNumber 98-524 Date Issued 6-24-98
Expiration Date 6-22-2003

This permit is issued by the Union County Health Department to construct and install the work hereby described. The construction shall be made in compliance with the N.C. Department of Environment, Health, and Natural Resources' Laws and Regulations for Sanitary Sewage Collection, Treatment, and Disposal, 10 NCAC 10A. 1900, and the Union County Health Department Rules and Regulations. Any unauthorized changes to the site or system design shall void this permit.

OWNER: KAREN KAMFEN TANNERMailing Address 2100 EIGHTON RD City/State/Zip Code CHARLOTTE NC 28211PH: (w) 423-8213
(h) 865-4105Location LESTER DAVIS RD. Subdivision _____

Phase _____ Section _____ Lot No. _____

DIRECTIONS: HWY #84 @ LESTER DAVIS RD. PROPERTY ON @ BEFORE NEW TOWN RD.

Installation For: House _____ Duplex _____ Mobile Home _____ Number of Bedrooms _____ Garbage Disposal: yes _____ no _____

Commercial _____ Industrial _____ Other (Describe) BARN WITH 1 BEDROOM APARTMENT ABOVE Number of Employees: _____

Church _____ Kitchen Facilities: yes _____ no _____ Seating Capacity of Sanctuary _____ Day Care: yes _____ no _____

New Installation _____ Design Waste Flow _____ 240 G.P.D.Type of system: Conventional _____ Modified Conventional _____ Pump-to-Conventional _____ LPP _____ Mound _____ At-Grade Mound _____
Other (Describe) _____Septic Tank: Capacity 1000 gal. Compartments: 2 Dimensions (If custom/site built): L _____ W _____ Liquid Capacity: _____

Pump Tank: Capacity _____ gal. Pump Flow _____ gal./minute at _____ feet of Total Dynamic Head _____

Drainfield: Total Length of Lines 300 feet Total square feet of disposal area 900 sq. ft. Line Length 75'Line Width 36 inches Filter Material & Depth 12" OF #5 WASHED STONEMaximum depth of lines 20" Maximum Grade 2.25' / 10' Distribution Device DISTRIBUTION BOX - CONCRETESystem distance to nearest: Well 100' Water Line 10' Foundation 10' Property Line 10' (USE SPEED LEVELERS)

Addition/Repair _____ Previous On-Site Wastewater System Permit Number _____ Dated _____

Repair Components: Septic Tank _____ Cap. _____ gal. Pump Tank _____ Cap. _____ gal. Pump _____ TDH Req. _____

Drainfield _____ Total Length _____ Individual line length _____ Line width _____ Filter Material & Depth _____

Water Supply: Individual Well ☒ Public Water _____ Other _____

Comments & Special Conditions:

PLEASE CONTACT ENVIRONMENTAL HEALTH WITH ANY QUESTIONS REGARDING THIS PERMIT.

I hereby certify that this application has been prepared and the work will be done in accordance with the Ordinances, State Laws, Rules and Regulations of the State of North Carolina and Union County Health Department. NOTICE: The issuance of this permit does not relieve the property owner of his responsibility for checking his proposed development with applicable zoning regulations.

Permit Prepared By: Sherry R. S. Date 6-22-98Signed: Kathryn J. Lamm Contractor: RCS INCFinal Inspection By: Sherry R. S. Date 1-18-99

Certified Operator: _____

TO LESTER DAVIS ROAD

321.97'

Absolutely no part of system shall be installed while soil is in wet condition. Any unauthorized changes to system, lot configuration, building site, or site conditions may void permit. Copy of permit shall be on site at all times during construction of system. Representative of installer shall be on site during system inspection.

(3) CONTRACTOR MUST MEET WITH ENVIRONMENTAL HEALTH SPEC MUST PICK UP INSTALLATION.

(4) DRAINFIELD MUST BE INSTALLED INSIDE DESIGNATED EASEMENT AREA

(5) NO INSTALLATION WHILE SOIL IS WET

(6) 20" MAXIMUM TRENCH DEPTH FOLLOWING CONTOUR OF LAND

(7) KEEP TRENCH BOTTOM SHALLOW

GRAVELED EASEMENT AREA

PIPE 15" DIA. 15' LONG



Scale: 1" = 60'

Direction of North:

