

Date 3/31/99
Receipt # 16024

YADKIN COUNTY HEALTH DEPARTMENT
ENVIRONMENTAL HEALTH SECTION
(910) 679-4244

No 013731

☐ Repair Permit ☒ Improvements Permit-5 Year ☐ Improvements Permit-WOE ☒ Authorization to Construct ☒ Well Permit


☐ Owner; ☐ Buyer; ☐ Agent; NAME CARWALL PIN # 5818 16 5838
Address P.O. BOX 1621 YADKINVILLE, NC 27055 Sub-Division Eagles Nest
Phone: Home 679-4850 Day _____ Sect. _____ Lot # 4
State Road No. _____ Road Name _____ Directions 601 N, TR Country Club
Rd., TR Brookhaven Lane, 4th LOT on left.

☐ In-City / 1 mile; ☐ 2 Mobile Homes on Property; ☐ County Zoned; ☐ Watershed III IV ☐ Plat Attached

FACILITY
☒ House 3 Bedrooms ☒ Basement NO
☐ Mobile Home 2 1/2 Baths ☒ Basement Bath NO
☐ Church _____ Seats _____
☐ Business _____ Employees _____ Other _____

WATER SUPPLY
☒ New _____ Existing _____ Replacement _____
_____ Private _____ Community _____ Public _____
Permit by Mike Williams R.S. Date 4-27-99

SYSTEM SPECS
☒ New Installation _____ Repair Fall/100' Line = 0" LTAR: 4
Tank Size 1200 gal. Max. Trench Depth start at 30"
Linear Ft. 340 " Cover 18" + "
Stone Depth 12" " No. Boxes 2 No. Lines 3
System Type: CONV. Class: RS
Repair Type: CONV. Class: RS

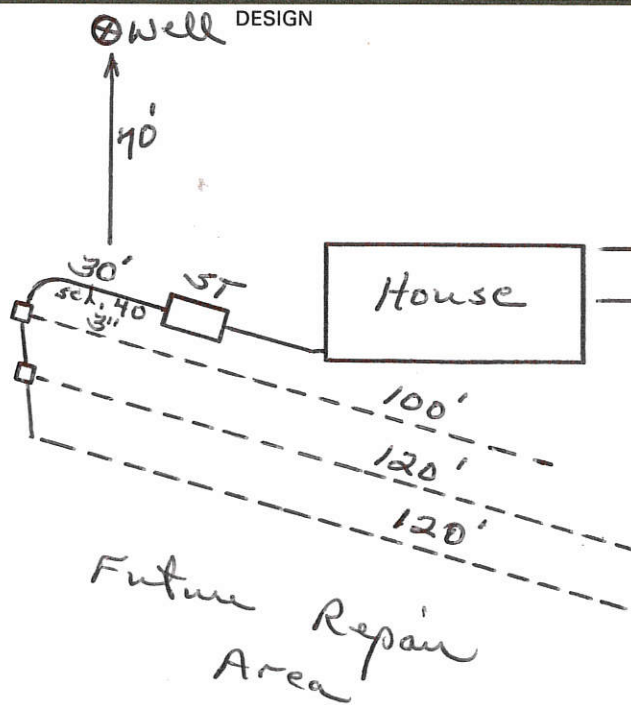

ACTUAL INSTALLATION

START LINES AT 30"
+ dig level.
Will be deep in
front of house.
(illegal fill dirt)
Lines will go in
natural soil.

Installed By: HB

Requirements/Comments: _____

★ Improvements Permit (NOT APPROVAL for building permit) By: Mike Williams R.S. Date: 4-27-99
★ Authorization to Construct (APPROVAL for building permit) By: Mike Williams R.S. Date: 4-27-99
★ Operation Permit (Conditions may be placed on OP) By: Mike Williams R.S. Date: 10-18-00
★ Authorization to Construct valid for 5 years. Any alteration of site may nullify improvements permit or authorization . . . they may be suspended or revoked upon a finding that a violation of Article 11 Chapter 130A, 1900 of Title 15A Subchapter of the N.C. Adm. Code, or a condition imposed upon the Improvements Permit or Authorization has occurred . . . also upon finding that issuance was based on incorrect or inadequate information. Form 97-F-2-JWC