

53086

Control No.

**STATE OF OREGON
DEPARTMENT OF ENVIRONMENTAL QUALITY**

PERMIT NO. SWR2001-00105-MAJ

\$ 280.00
Fee

☐ New Construction

☒ Repair **Major**
☐ Other _____

 Permit Issued To Leona Roberts
 76248 (Property Owner's Name)

T7N
 (Township)

R3W
 (Range)

08
 (Section)

000-00400
 (Tax Lot / Acct. No.)

Columbia
 (County)

76284 Delena Mayger Rd.
 (Road Location)

Rainier
 (City)

Hal Wilson
 (Issued by - Signature)

11-9-00
 (Date Issued)

PERMITS ARE NOT TRANSFERABLE

ALL WORK TO CONFORM TO OREGON ADMINISTRATIVE RULES, CHAPTER 340. WORK SHALL BE DONE BY PROPERTY OWNER OR BY LICENSED SEWAGE DISPOSAL SERVICE. (MAKE NO CHANGES IN LOCATION OR SPECIFICATIONS WITHOUT WRITTEN APPROVAL)

SPECIFICATIONS

 EXPIRATION DATE 11-9-01

 TYPE OF SYSTEM Standard - Repair

 Design Sewage Flow 450 Gallons/Day

 Tank Volume 1000 Gallons

 Disposal Trenches ☒

 Seepage Bed(s) ☐ 750 Square Feet

 Maximum Depth 30 inches.

 Minimum Depth 24 inches.

375 Linear Feet

 Equal ☐ Loop ☐ Serial ☒

 Pressurized ☐

 Minimum Distance Between Trenches 10' on centers

 Total Rock Depth 12 inches.

 Below Pipe 6 inches.

 Above Pipe 2 inches.

☐ Rake Sidewall

Special Conditions (Follow Attached Plot Plan) _____

PRE-COVER INSPECTION REQUIRED — CONTACT _____

CERTIFICATE OF SATISFACTORY COMPLETION

 As-Built Drawing
 with Reference Locations

 Installer Don Hooper

 Final Insp. Date 11-16-00

 Inspected By H. Wilson

SEE PLOT PLAN

☐ Issued by Operation of Law

☐ Pre-cover inspection waived
 pursuant to OAR 340,
 Division 71

In accordance with Oregon Revised Statute 454.665, this Certificate is issued as evidence of satisfactory completion of an on-site sewage disposal system at the location identified above.

Issuance of this Certificate does not constitute a warranty or guarantee that this on-site disposal system will function indefinitely without failure.

Hal Wilson
 (Authorized Signature)

Sanitarian
 (Title)

11-16-00
 (Date)

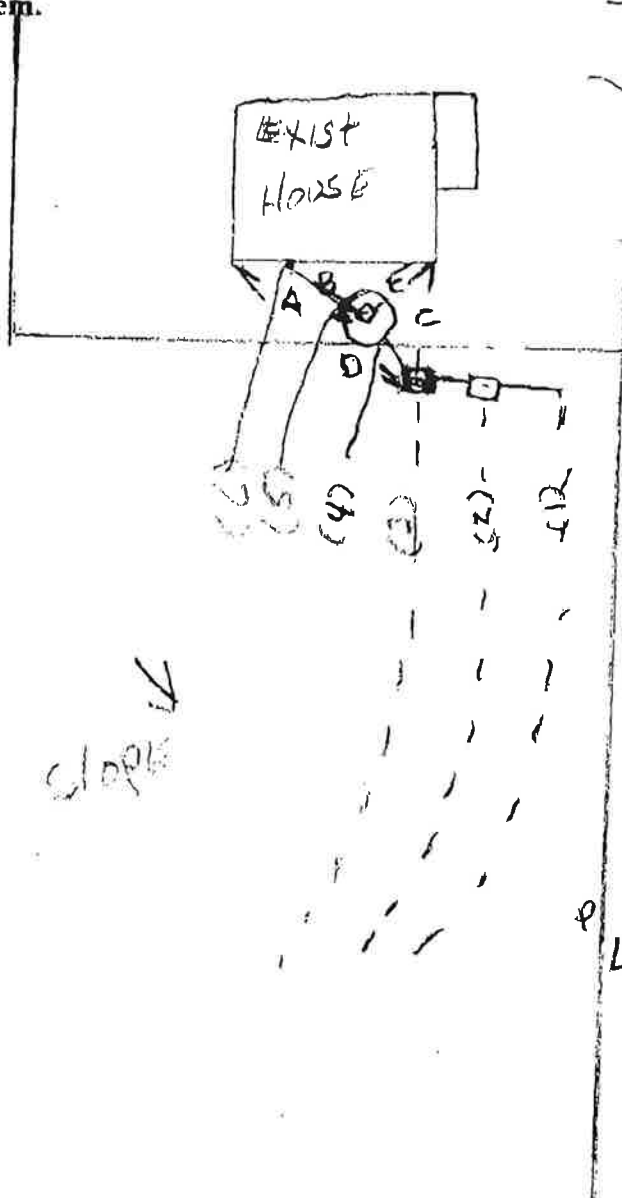
(Office)

Property Owner

LEON ROBERT

SWR 2001
Permit Number 00105 MAT**SECTION 3:****AS-BUILT PLAN OF THE CONSTRUCTION SYSTEM.**

Indicate the direction of NORTH and show the locations of all wells within 200 feet of the system.

Well
40' +
↑
↑
N

A = 21' 1 = 0"
 B = 14.5' 2 = 22"
 C = 21' 3 = 37"
 D = 36' 4 = 73"
 E = 13' 5 = 76"
 6 = 96"

MAYGARD DELERNA ROAD

P L

SECTION 4:**CONSTRUCTION WAS PERFORMED BY:**

Property Owner

Licensed Septic Installer

DON HOOPER INC 34811
(Print Full Business Name & License Number)

certify the information provided in this notice is correct, and that the construction of this system was in accordance with the permit and the rules regulating the construction of on-site sewage disposal systems (OAR Chapter 340, Divisions 71 and 73).

(Signature of Installer)

(Date)

11-16-00

AS-BUILT AND FINAL INSPECTION

Pursuant to the requirements within ORS 454.655, OAR 340-71-170 and OAR 340-71-175, the system installer and/or the permittee must notify the Department of Environmental Quality (or its authorized Agent) when the construction, alteration or repair of a system for which a permit was issued is completed (except for the backfilling or covering of the installation). The Department (or Agent) has 7 working days to perform an inspection of the completed construction after the official notice date, unless the Department (or Agent) elects to waive the inspection and authorizes the system to be backfilled earlier. Receipt and acceptance of this completed form by the Department (or Agent) establishes the official notice date of your request for the pre-cover inspection. Please complete all four sections of the form and return it to the office that issued the permit. Forms that are determined to be incomplete will be returned.

SECTION 1: BASIC INFORMATION

Property Owner LEONARD ROBSON Permit Number 56102001 00105 MRS
Tax Account Number 470 B3W 08 000-00400
Job Location 76284 DELORA MAYGEO RD
Date System Construction Completed 11-16-00; Date Submitted 11-16-00

SECTION 2: MATERIALS LIST

1000 GAL CONTAINER SEPTIC TANK MICHAELS
DROP BOXES PORCELAN
PTR & FITTINGS FAMILY ALL
DRAIN ROOF MORSE BROS DECKING