

STOKES COUNTY HEALTH DEPARTMENT SEPTIC TANK LAYOUT AND PERMIT

Owner or Contractor Don Hardin Date 3/23/82
Directions & S.R. Number SLATE RD OFF MTN VIEW log cabin ON L
1 mi from mtu view 2710 Slate Rd??

Permit No.: 82-261
House ☒ Business ☐
Mobile Home ☐ Other ☐
New Installation ☐ Repair ☐

No. of Bedrooms 1

Lot Size Farm

Perc Tests (1) 45 (2) 45 (3) 45 MPI


Size of Tank 800 Gal.

Nitrification Line 800 Sq. Ft./ 200 Lin. Ft.

Stone Depth 12 Inches

Water Supply king

Layout By p

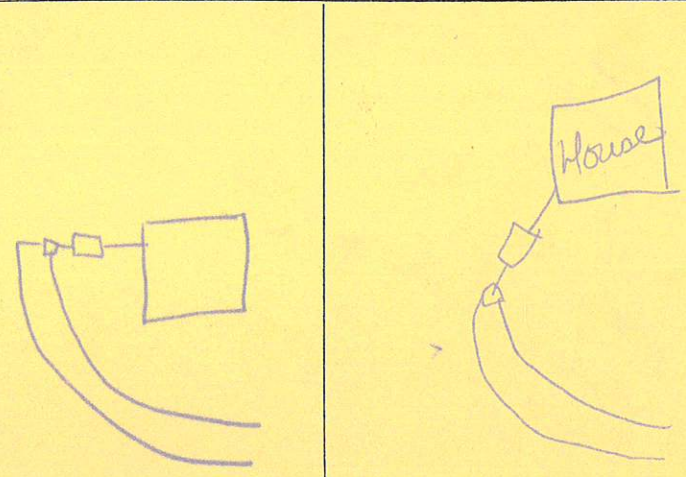

Suggested

Front

Final

Comments 9-10-82 Bob McHone - Pinnacle Robert

Date 10-1-83 Installed By 09-01743 6913-04-71 6100 Approved By