

Wis. Department of Health and Human Resources
Bureau of Public Health
Division of Environmental Health Services
ENVIRONMENTAL ENGINEERING DIVISION

SW223
1001

WELL COMPLETION REPORT

Project: 7-20-06 Permit: OW 19-06-111
Name: WILLIAM D. SMITH Area Name/Location: DILLON'S ESTATE
Well Name: WELL 1 Address: 1001 FOX RD
Telephone Number: 214-254-2112 WILLOW LEAF, WY 26765
Well Name: WELL 2 Address: P.O. BOX 440
Telephone Number: 214-254-2112 PRINGFIELD, WY 26763

WELL LOG

DEPTH IN FEET	FORMATION ROCK, SOIL, SAND, AND WATER BEARING	REMARKS
0-10	GRAVEL	Type of Well: <u>DOMESTIC</u> Drilling Method: <u>AIR LIFT</u>
10-20	GRAVEL	Well Diameter: <u>6"</u> Casing O.D.: <u>6.75"</u>
20-30	GRAVEL	Well Depth: <u>160'</u> Date Completed: <u>7-20-06</u>
30-40	GRAVEL	CASING: Length <u>30</u> Feet Height above ground <u>1</u> Feet
40-50	GRAVEL	☒ Steel ☐ Plastic ☐ Cast Iron
50-60	GRAVEL	Other _____ Type _____
60-70	GRAVEL	SCREEN
70-80	GRAVEL	☐ None Installed
80-90	GRAVEL	Type: <u>PVC</u> Diameter: <u>4"</u>
90-100	GRAVEL	Slot/Gauge: <u>.02</u> Length: <u>16</u>
100-110	GRAVEL	Set Between: <u>144</u> Ft. and <u>160</u> Ft.
110-120	GRAVEL	
120-130	GRAVEL	
130-140	GRAVEL	
140-150	GRAVEL	
150-160	GRAVEL	

PUMPING OR BAILING TEST

DETAIL	#1	#2	#3
Static Water Level (Ft. Below Grade)	<u>35</u>		
Pumping Rate (GPM)	<u>25</u>		
Pumping Level (Ft. Below Grade)	<u>140</u>		
Duration of Test (In Hours)	<u>1</u>		
Recovery Time to Static Level (In Hours)	<u>1/2</u>		

WELL HEAD

Pillazo Adapter: Type, Make, Etc. _____
Well Cap: Type, Make, Etc. _____
Well Seal: Type, Make, Etc. _____
Well Platform _____
Length _____ Width _____ Thickness _____
Grouting: ☒ Yes ☐ No
All Public Water Supplies must be grouted.

I hereby certify that this well was drilled and constructed under my supervision, in compliance with all requirements of the referenced permit, and that this record is true to the best of my knowledge and belief.

Name

Registered Business Name

Signed

Certification No.

Date

R. MARK SMITH

WAL SMITH WELL DRILLING

2/2/06

001

7-20-06

INSPECTION TO BE
PRINTED OR TYPED

STATE OF WEST VIRGINIA

HEALTH DEPARTMENT

County: W. VIRGINIAON-SITE SEWAGE DISPOSAL SYSTEM
INSPECTION FORMPermit No.: ST-14-06208Tax Map: 17 Parcel #: 49

County Road: _____

Name of Owner: DAVID FEAUSTAKInstaller: EDWIN MCKEEAddress: HC 82, BOX 30, YELLOW SPRING, WV 26086Property Location: DILLON'S RUN ESTATES LOT #18Type of Facility: HOUSEFacility is: New (☒) Existing () Lot Size: 5.08 Sq. Ft. (Acres)Design Loading in gpd/No. Bedrooms: 400 Source of Water Supply: Well

SEWAGE TANK COMPONENT

Capacity in Gallons: 1000 Material: Concrete Manufacturer: J.I.T.Distances (in feet) of Tank to: Dwelling: 52 Private () / Public () Water Source: 80 Property Line: 107

ON-SITE DISPOSAL SYSTEM

Class I Systems: Standard Soil Absorption Trenches () or Bed () Gravelless Pipe (), Diameter: _____ Inches

Class II Systems: Pumped/Dosed Soil Absorption Trenches () or Bed () Evapotranspiration Trenches () or Bed ()
Shallow Soil Absorption Trenches () or Bed () Other: _____No. of Lines: 4 Length (in feet) of Each: 80, 80, 80, 80
Width of Trenches: 36 inches/feet Depth to Bottom of Field: 24 InchesIf Bed, Dimensions (in Feet): _____ If Chamber System, Name: INF-4, No. of Units: 80Approved and Adequate Materials Used? Yes (☒) No () Size Equates to: 1600 Square Feet of Standard Gravel Field.Distances (in feet) of System to: Dwelling: 110 Private () / Public () Water Source: 107 Property Line: 107

Remarks: _____

An inspection indicates that the sewage disposal system described above

DOES MEET (☒)

DOES NOT MEET (),

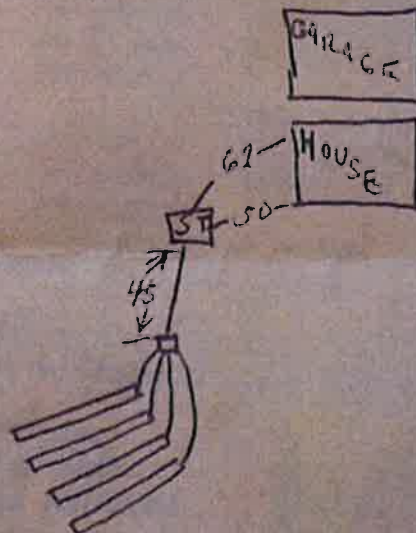
CANNOT BE DETERMINED TO

MEET () the minimum standards established by the West Virginia Bureau of Public Health.

To correct a health hazard, modifications to existing systems may be done to improve part of a system. Such modifications may not be able to be designated as a does meet system since adequate information is known.

Although many factors contribute to the successful functioning of a sewage disposal system, this office recommends water conservation and maintaining an even usage of water throughout the week.

Sketch of Installation with Triangulation or Distance to Specific Landmarks:

well

Draw Arrow
toward North

NOT TO SCALE

Visit Date(s): 11-22-05Final Inspection Date: 10-2-06

Sanitarian: _____