

RANDOLPH COUNTY HEALTH DEPARTMENT SEPTIC TANK LAYOUT AND PERMIT

Sub-Division Pat Leonard Properties

Sect. No. _____

Lot No. _____

PIN 8725395768

No. A-900-1836

Owner or Contractor J. B. Loflin

ORIGINAL

Logged Kgl

now

Directions & S.R. Number 49 N Life Hwy 421 1st Left 1st R+ well on Rt Date 10 22 90/11/91

☒ New

☐ Repair

☒ House

☐ Business

☐ Mobile Home

☐ Other

Design Sewage Flow 360 gpd

Lot Size 25 AC


Size of Septic Tank 900 1000 G3T Gallons

Pump ☒ Size 156 PM @ 12" HEAD Tank Size 900 1000 gals

Zoller N97-1/2 HP Nitrification Line 1,200 Square Ft.

Material Under Line 6 Inches

Layout By J. D. Wakeman Jr.

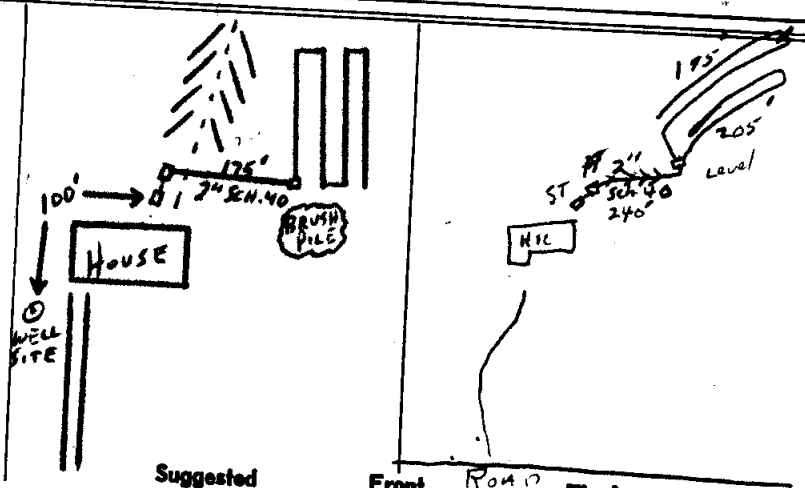

Comments New permit replaces permit dated 10/23/90

Date 2-5-1992

(Revised 8/89)

Installed By Ward Bear

#47 Hulan

Approved By J. Chandler R.S.