

SS-177
Rev 6/11West Virginia Department of Health & Human
ResourcesPermit #: **ST-14-16-78**Lat: N: 39 20 47.2Hampshire County Health Department

Tax District Name: _____

Long: W 78 47 19.9**ON-SITE SEWAGE DISPOSAL SYSTEM
INSPECTION REPORT**Map # 22 Parcel # 52Name of Owner: Seyed Bahram Sadighian Installer: Eugene RinkerOwner Address: 4110 Ferry Landing Rd, Va 22309Property Location: High Mtn OrchardSubdivision: High Mtn Orchard Lot number: Lot 23Type of Facility: new Facility is: New x Existing ☐ Lot Size (ft²/acres): 5.3 acresDesign Loading: Bedrooms: 2 or GPD: _____ Water Supply: Existing: ☐ Proposed ☐ Type: cistern**System requires a perpetual maintenance program as per 64CSR9.7.2: Yes ☐ No ☐****SEWAGE TANK COMPONENTS**

SEPTIC TANK	Sub	Comp	Pump Chamber
Capacity in Gallons	<u>1000</u>	<u>NA</u>	
Constructed of	<u>Concrete</u>	<u>>100'</u>	
Manufacturer	<u>Jolin</u>	<u>>100'</u>	
Inspection port	<u>riser</u>	<u>no</u>	

ABSORPTION FIELDClass I System: Chamber: x Eljen ☐ Gravelless Pipe: ☐ Gravel Media Trenches ☐ Other: _____Manufacturer: Infiltrator Square footage: Permitted 900 ft² Installed 900 ft²Number of lines: 3 Trench width: 36 inchesLengths of lines: 60' 60' 60' _____, _____, _____, _____, _____, _____, _____Distribution box used? Yes x No ☐ Outlets level? Yes x No ☐If chambers, length of each section: 4' Gravelless pipe diameter: _____

If bed configuration used, dimensions: _____ X _____ Maximum depth to bed bottom on upslope side: _____



Distance of absorption field to: Dwelling: NA, Water Supply: >100', Water Line: _____, Property Line: >100'Average Depth: 24in Maximum depth: 27in

Class II System: Design type: _____

Remarks: Dwelling not constructed at time of inspection**System is installed as per the permitted design and layout. Yes x No ☐**

**Sketch of Installation with Triangulation or Distance to Specific Landmarks.
Include reserve area boundaries.**

END:

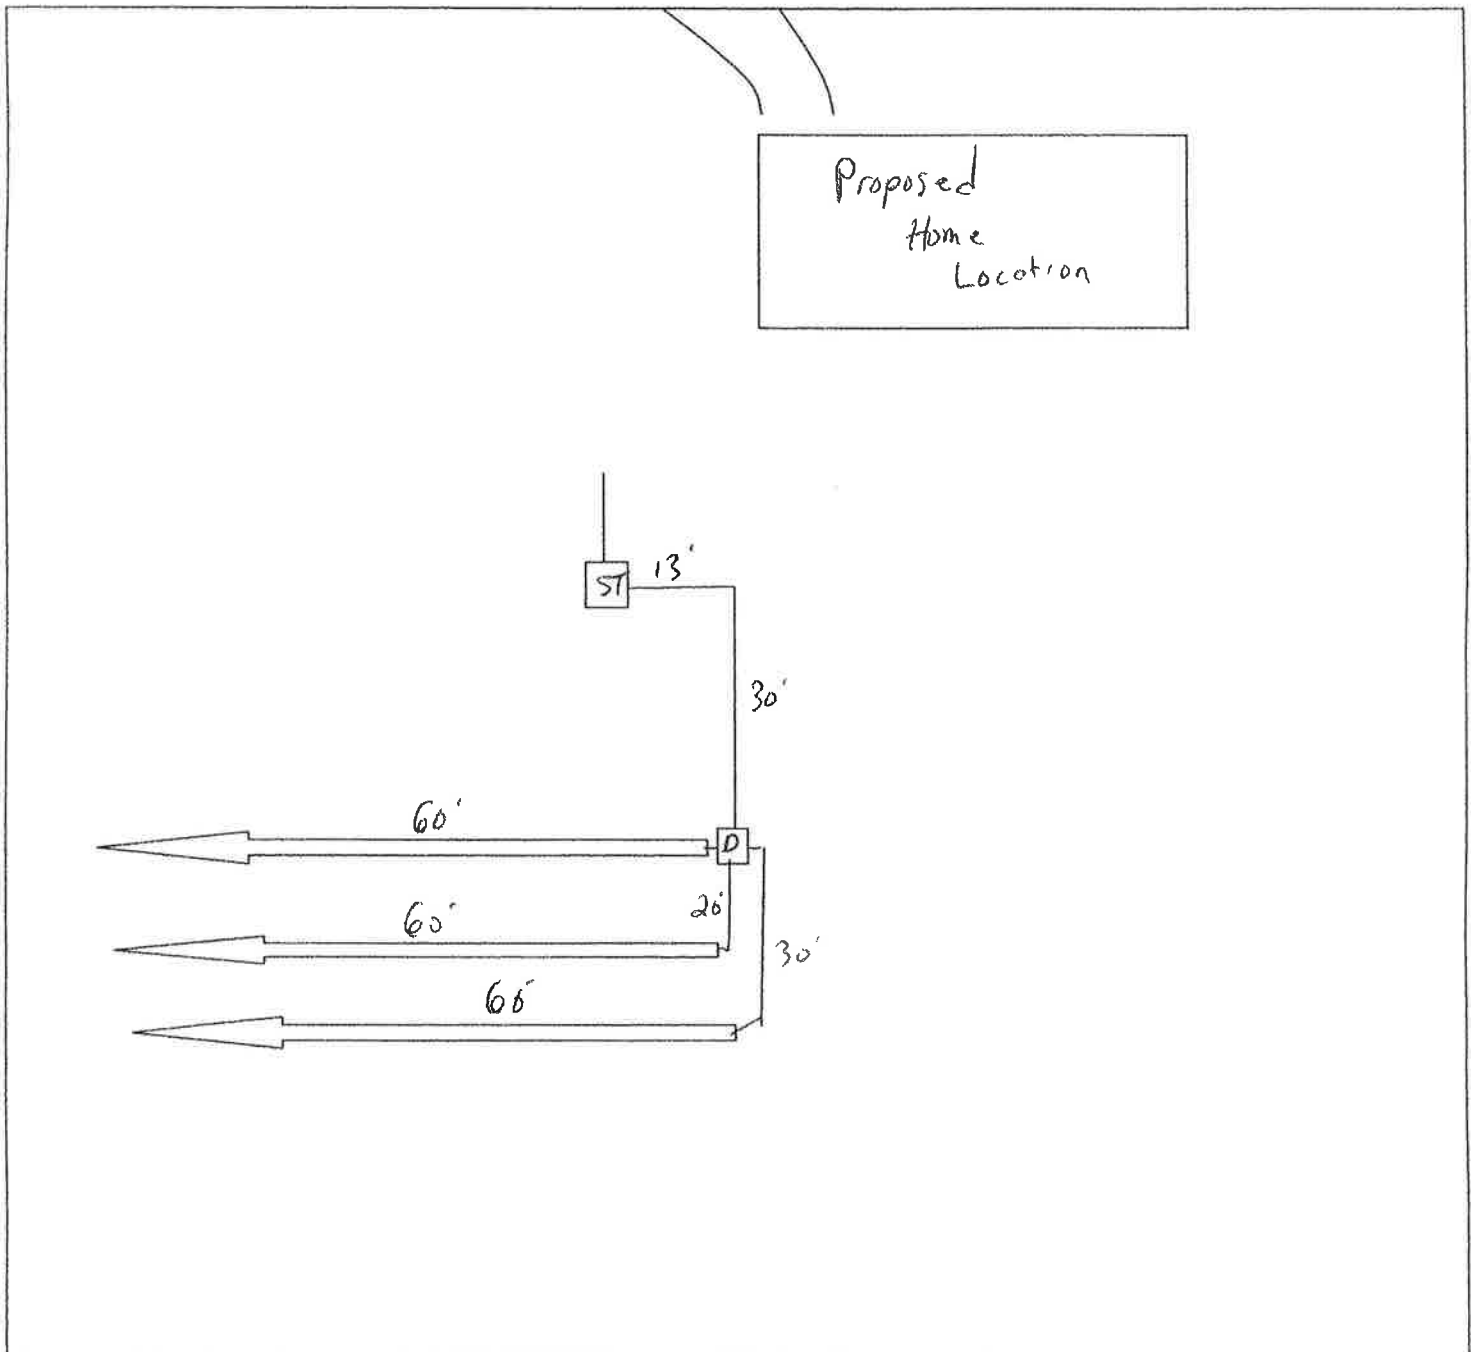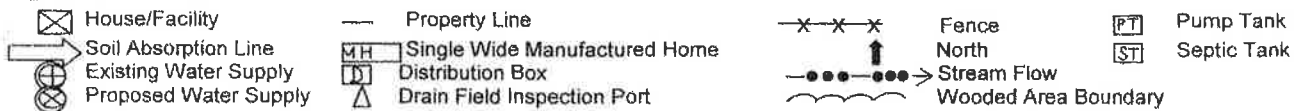

System is: **Approved x** **System is NOT Approved:** ☐

COMMENTS: _____

Dates visited: 6/3/2016


Sanitarian

7/8/2016
Date Final Issued