

STATE OF WEST VIRGINIA

INSPECTION TO BE
PRINTED OR TYPED

HEALTH DEPARTMENT

Permit No.: ST-14-07-281Tax Map: 5 Parcel #: 5

County Road: _____

County: W. VIRGINIA ON-SITE SEWAGE DISPOSAL SYSTEM
INSPECTION FORM

Name of Owner: Robert Fenton Installer: same
 Address: P.O. Box 32 Kearneysville, WV 25430
 Property Location: CARON GLEN SECTION 2 LOT #5
 Type of Facility: HOUSE Facility is: New ☒ Existing ☐ Lot Size: 6.4 ~~Sq. Ft.~~ Acres
 Design Loading in gpd/No. Bedrooms: 2 BR Source of Water Supply: well

SEWAGE TANK COMPONENT

Capacity in Gallons: 1200 Material: concrete Manufacturer: Volvo
 Distance (in feet) of Tank to: Dwelling: 21 Private ☒ Public ☐ Water Source: 50+ Property Line: 10+
to be

ON-SITE DISPOSAL SYSTEM

Class I Systems: Standard Soil Absorption Trenches ☐ or Bed ☐ Gravelless Pipe ☐ , Diameter: _____ Inches
 Chamber Soil Absorption Trenches ☒ or Bed ☐
 Class II Systems: Pumped/Dosed Soil Absorption Trenches ☐ or Bed ☐ Evapotranspiration Trenches ☐ or Bed ☐
 Shallow Soil Absorption Trenches ☐ or Bed ☐ Other: _____

No of Lines: 3 Length (in feet) of Each: 80, 80, 80
 Width of Trenches: 36 inches/feet Depth to Bottom of Field: 24-36 inches
 If Bed, Dimensions (in Feet): _____ If Chamber System, Name: INF-4 , No. of Units: 60
 Approved and Adequate Materials Used? Yes ☒ No ☐ Size Equates to 200 Square Feet of Standard Gravel Field.
 Distance (in feet) of System to: Dwelling: 50 Private ☒ Public ☐ Water Source: 100+ Property Line: 10+
to be

Remarks: _____

An inspection indicates that the sewage disposal system described above
DOES MEET ☒,
DOES NOT MEET ☐,
CANNOT BE DETERMINED TO MEET ☐ the minimum standards established by the West Virginia Bureau of Public Health.

To correct a health hazard, modifications to existing systems may be done to improve part of a system. Such modifications may not be able to be designated as a does meet system since inadequate information is known.

Although many factors contribute to the successful functioning of a sewage disposal system, this office recommends water conservation and maintaining an even usage of water throughout the week.


Sketch of Installation with Triangulation or Distance to Specific Landmarks:

7-2-04
 No Well

Not to Scale



Draw Arrow
toward North

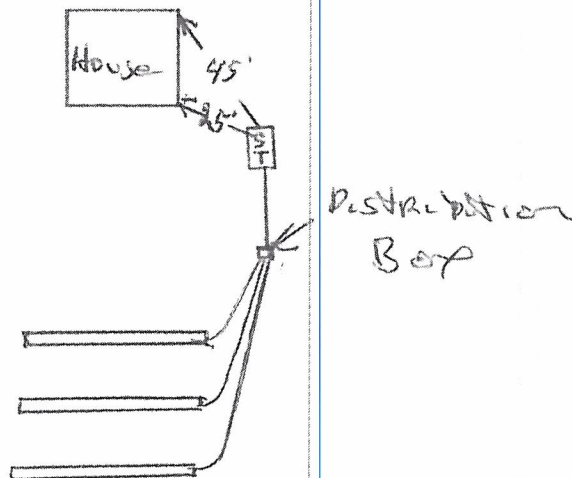Visit Date(s) 5-24-04Final Inspection Date: 7-2-04Sanitarian: J. L. Lumb

WV Department of Health and Human Resources
Bureau of Public Health
Office of Environmental Health Services
ENVIRONMENTAL ENGINEERING DIVISION

SW258
10/01

Rec
1-27-06

WELL COMPLETION REPORT

Date(s) 1-16-06 County Hampshire Permit #: DW1406149
Town: Capon Bridge Area Name/Location Capon Glen Lot 5 Sycamore Road
Well Owner: Robert & Tammy Fenton Address: 105 Derik Court
Telephone Number: (304) 264-0625 Martinsburg WV 25401
Well Driller: Miller Brothers Drilling LLC Address: PO Box 952
Telephone Number: (304) 822-4092 Romney WV 26757

WELL LOG

DEPTH IN FEET	FORMATIONS: KIND, THICKNESS, AND IF WATER BEARING	REMARKS:
0-30	Brown shale	Type of Well: <u>Drilled</u> Drilling Method: <u>Air rotary</u>
30-50	Blue shale	Well Diameter: <u>6 1/8"</u> Casing O.D.: <u>7"</u>
50-200	White sandstone with soft streaks	Well Depth: <u>520'</u> Date Completed: <u>1-16-06</u>
200-364	White sandstone	CASING: Length <u>100</u> Feet Height above ground <u>1.5</u> Feet
364-520	Sandstone with broken streaks	☐ Steel ☒ Plastic ☐ Cast Iron
		Other _____ Type _____
		SCREEN <u>420' 4" certalok liner</u>
		☒ None Installed
		Type _____ Diameter _____
		Slot/Gauge _____ Length _____
		Set Between _____ Ft. and _____ Ft.

PUMPING OR BAILING TEST

DETAILS	#1	#2	#3
Static Water Level (Ft. Below Grade)	<u>120</u>		
Pumping Rate (GPM)	<u>60</u>		
Pumping Level (Ft. Below Grade)	<u>518</u>		
Duration of Test (In Hours)	<u>4</u>		
Recovery Time to Static Level (In Hours)			

WELL HEAD


Pitless Adapter: Type, Make, Etc. _____
Well Cap: Type, Make, Etc. _____
Well Seal: Type, Make, Etc. _____
Well Platform:
Length _____ Width _____ Thickness _____
Grouting: ☒ Yes ☐ No
All Public Water Supplies must be grouted.

I hereby certify that this well was drilled and constructed under my supervision, in compliance with all requirements of the referenced permit, and that this record is true to the best of my knowledge and belief.

Bobby Allred 602
Name Certification No.
Miller Brothers Drilling LLC 1-16-06
Registered Business Name
Bobby Allred _____
Signed Date

Please draw a sketch of the property showing existing or proposed well with locations, and distance to structures, existing or proposed sewage systems within 200 feet of well location, slope and lot dimensions. Locate and show distances to animal pens, barnyards, or any other factors which may be a possible source of contamination for the water supply.

- ☒ House
 --- Soil Absorption Line
 |||| Trees
☒ Water Supply
 → Dir. Of Ground Slope
 (P) Percolation Test Site
 ST Septic Tank
 MH Mobile Home
 _____ Property line

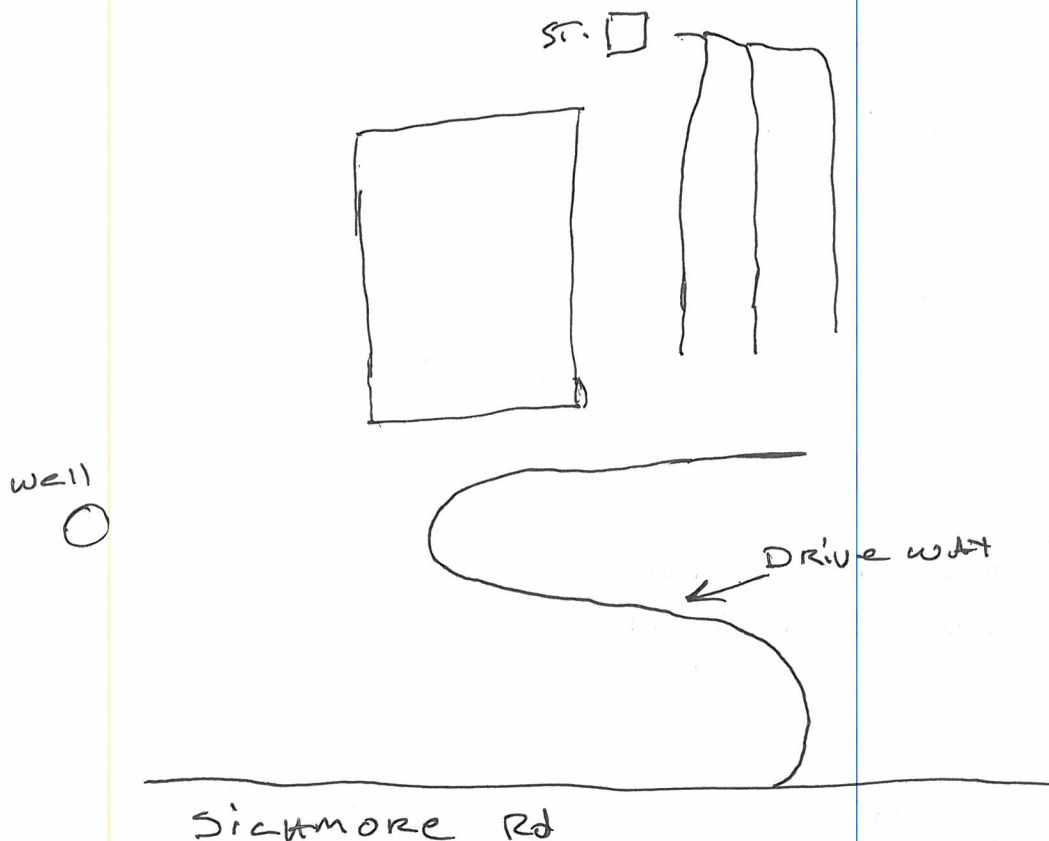

FOR HEALTH DEPARTMENT USE ONLY County: _____ Coordinates N _____ W _____ Date Recv'd. 11/4/05
 Date Site Evaluation _____ Reviewed by _____ Date Fee Paid _____ Received From _____
 Contractor's Bond/Letter of Credit Exp. Date Verified By _____ Liability Insurance Exp. Date Verified By _____
 Water Well Permit ☐ Issued ☐ Denied Permit No. _____ Comments _____