

DISTRICT SEVEN HEALTH DEPARTMENT SEPTIC PERMIT

NOTE THIS PERMIT IS ONLY VALID FOR ONE YEAR FROM DATE OF ISSUE

4/99

Installation shall comply with all the requirements of the Health District and Idaho's Individual Subsurface Sewage Disposal Regulations as stated below. Failure to install system in compliance with permit will cause disapproval by District 7 and possible legal action.

GDP No. 138961 F-Code: 232 Time: 15 MIN Permit No. 99-69
Receipt No. _____

Permit Issued To: Name JOHN ECKLESDATER Phone 523-7719

For Location: Address 316 HARTERT DR. IDAHO FALLS 83404 City SHOUP Zip _____
PANTHER CREEK AT BIRCH CREEK

Legal Description: $\frac{1}{4}$ Section _____ Section 10 Township 22N Range 18E

Subdivision _____ Lot _____ Block _____

SEPTIC TANK SPECIFICATIONS (minimums)

Size of Septic Tank: 1000 gallons Multiple tank (if using or required): _____ Total gallons _____

First tank: _____ gallons Second tank: _____ gallons

Pump Chamber (if required): _____ gallons

SEWAGE DISPOSAL (DRAINFIELD) SPECIFICATIONS (minimums)

Type(s) of Standard Sewage Disposal System Permitted: Trench X Bed _____ Pit _____ Gravelless X
Basic Alternative Privy X Steep Slope System _____ Capping Fill X Extra Drain-rock Trench _____

Type(s) of Complex Alternative Disposal System Permitted: Sand Filter Intermittent _____ Sand Filter Intrench _____
Sand Mound _____ Lagoon _____ Extended Treatment Systems _____ Large Soil Absorption Systems _____
Other _____

Complex Alternative Disposal Systems are required to be installed by a licensed complex installer

MAXIMUM DEPTH OF EXCAVATION: 1 Feet DISPOSAL AREA SIZE: 500 Sq. Ft.

SOIL TYPE: B APPLICATION RATE: 5 gals/day/ft²

DISTANCE TO NEAREST SURFACE WATER (explanation): SYSTEM MUST BE AT LEAST 200 FT FROM THE
NEAREST SURFACE WATER

SPECIAL CONDITIONS

MAXIMUM DEPTH BASED ON 5 FT DEPTH OF TESTHOLE. IF SOILS WITH DEPTHS OF 6 FT OR GREATER ARE FOUND, MAX. DEPTH WILL BE 2 FT.

Renew permit 8/31/00 - called 8/31/00 to do burn area. asked for landscape assistance - I gave it to him.

I hereby agree that the system will be installed as per the permit and will not make any changes from the permit without written approval from District 7. I also hereby authorize access to my property for purposes of inspection.

Applicant/Agent Signature John Ecklesdater Date 9-1-99

ISSUED BY EHS

Date Issued: 8/12/99

Expiration Date: 8/31/00

Note Other requirements on reverse side of permit:

10/30/01

DISTRICT SEVEN HEALTH DEPARTMENT SEWER APPLICATION

COUNTY 30

Shaded Area - OFFICE USE ONLY

7/26/99
R# 36217

 FEE PAID/Y
CDN#

ON-SITE CONDUCTED () APP () DISAPP

EHS#

DATE

TRAVEL TIME

ON-SITE TIME

NAME <u>John & Elizabeth Fekles</u>	PHONE <u>208 523-7719</u>	MAILING ADDRESS <u>316 Hartert Dr.</u> STREET/P.O. BOX CITY <u>Idaho Falls</u> STATE <u>ID</u> ZIP <u>83404</u>
PROPERTY ADDRESS STREET CITY ZIP		ORIGINAL OWNER'S NAME
		LOT SIZE (ACRES)
LEGAL DESCRIPTION: TOWNSHIP <u>22 N.</u> RANGE <u>18 East</u> SECTION <u>108.11</u> 1/4 SECTION <u>unsurveyed</u>		
SUBDIVISION LOT# BLOCK#		

 BRIEF DIRECTIONS TO PROPERTY: 6.5 miles from confluent of Panther Cr. & Salmon River
on USFS Rd #55 to new bridge entrance to property. See enclosed map.

TYPE OF USE (X) SINGLE FAMILY () MULTIPLE FAMILY () COMMERCIAL () OTHER	# BEDROOMS <u>3</u> # EMPLOYEES <u>Retired</u>	TYPE OF INSTALLATION <u>WOOD</u> (X) NEW () REPLACEMENT	WATER SUPPLY (X) PRIVATE () PUBLIC SYSTEM NAME	PROPOSED DISPOSAL SYSTEM (X) DRAINFIELD () PIT () ABSORPTION BED () BASIC ALTERNATIVE () COMPLEX ALTERNATIVE
*Additional information may be needed				

*IF COMMERCIAL/OTHER EXPLAIN

PLEASE COMPLETE THE GEOLOGICAL INFORMATION Approx.

HIGHEST NORMAL GROUNDWATER DEPTH <u>100</u> FT.	DEPTH TO BEDROCK <u>100+</u>	ROCK OUTCROPS () YES (X) NO
DESCRIBE SOIL (AT PROPOSED DEPTH OF DRAINFIELD) <u>silt + loam with</u> <u>flat rock + boulders</u>		() HILLSIDE (X) FLAT
NEAREST SURFACE WATER <u>400 ft</u>		WELL <u>None</u> SEPTIC <u>None</u>

The information provided on this application is accurate to the best of my knowledge. I understand that any false statements may result in disapproval of this permit. If this subsurface sewage disposal installation is constructed by anyone other than the home/landowner or a licensed septic installer, the installation will not be inspected or approved. Section 1-3006.01 - 1-3007.01.

 I am the: Landowner X Licensed Septic Installer _____ Building Contractor _____
 Installer License # _____

I hereby authorize the health authority to have access to this property for the purpose of performing the requested services and I certify that all the above information is accurate.

APPLICANT SIGNATURE

DATE

 SEE BACK FOR FURTHER INSTRUCTIONS AND DIAGRAM OF PROPERTY
 APPLICATION WILL NOT BE ACCEPTED W/O DIAGRAM ON BACK

DISTRICT SEVEN HEALTH DEPARTMENT

SEPTIC SYSTEM INSPECTION REPORT

Activity Code: 81

4/99

7/6/01 2:14 PM
7/3/01 2:42 PM

Inspection Time: 6:00

INSPECTION CONDUCTED FOR: Name JOHN ECKLEDAFER Permit No 99-69LOCATION OF INSPECTION: Street Address 316 HARTT DR. City IDAHO FALLS
Legal Description: 1/4 Section 10 Township 22N Range 18E S2404
Subdivision: PANTHER CK. AT BIRCH CREEK Lot Block


SEPTIC TANK INSPECTION

- Capacity of Septic Tank Installed 1000 gallons. Septic Tank capacity = or greater than permit requirements? ☒ Yes ☐ No ☐ N/A
- Was Septic Tank construction in compliance with State regulations and was tank State approved? ☒ Yes ☐ No
- Were inlet and outlet properly sealed? ☒ Yes ☐ No
- Did Septic Tank meet minimum separation requirements as required by permit? ☒ Yes ☐ No
- Was extension of manhole required? Yes ☒ No ☐ Depth from final grade to manhole, 18" feet
(RISK ON 2ND MANHOLE)

SUBSURFACE DISPOSAL (DRAINFIELD) INSPECTION

- Type of Disposal System installed GRAVELLESS TRENCH Meets permit requirements? ☒ Yes ☐ No ☐ N/A
- Disposal Area Size 396 Square Feet In compliance with Permit Issued? ☒ Yes ☐ No
- Did Disposal System meet the minimum separation distance as required by the Permit? ☒ Yes ☐ No
- Was Disposal System constructed in compliance with the State Technical Guidance Manual? ☒ Yes ☐ No
- Maximum depth of Disposal System 4' Feet In compliance with Permit Issued? ☒ Yes ☐ No

DRAWING: (Show buildings, septic system components, water lines, surface waters, & wells within 300 feet of septic system. Important to show distances.)

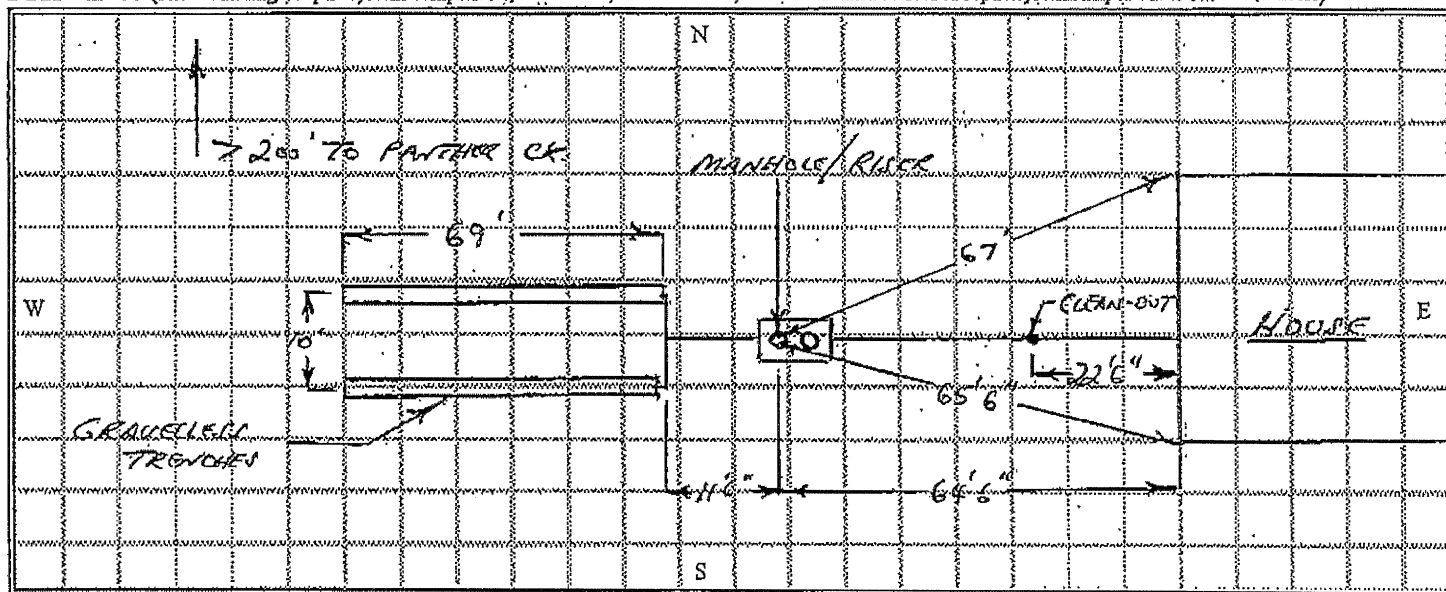

SELF-INSPECTION: If given approval for self inspection Installer certifies that information provided is accurate and system was installed as shown.

Installers Signature X _____ License #: _____ Date: _____

Official Use Only

Installed by: OWAGELicense #: N/A

This System appears to:

- Be in Substantial Compliance with permit and is approved ☒ Yes
- Have Minor deficiencies which could cause premature failure, but still in substantial compliance with intent of Rules. Recommend that deficiencies be corrected, which could improve your system, but system is still approved. Yes ☐ No ☐
- Have Major deficiencies which violate the intent of Rules and must be corrected, system not approved. Yes ☐ No ☐

Comments: RECOMMEND INSTALLING SLAB ABOVE TRENCHET PIPE
NO WELL AT TIME OF INSPECTION

INSPECTED/REVIEWED BY EHS: _____

John H. H. H.

DATE: 10/1/01