

**Hampshire County Health Department  
On-Site Sewage Disposal System  
Inspection Form**

**Permit # ST-14-10-79**

Name of Owner: Bristol Springs, LLC Installer: Gary Blankenship  
Address: P.O. Box 136, Slanesville, WV 25444  
Property Location: Bristol Springs Lot 2 Lot Size: 2AC Acres  
Type of Facility: Residence Facility is: ☒ New ☐ Existing  
Design Loading in gpd/# Bedrooms: 3 Source of Water: \_\_\_\_\_

**SEWAGE TANK COMPONENT**

Capacity in Gallons: 1000 Material: precast concrete Pump Chamber \_\_\_\_\_ gal  
Distances (in feet) of Tank to: Dwelling 22  
Private ☒ Public ☐ Water Source: 114 Property Line: 10+

**ON-SITE DISPOSAL SYSTEM**

Class I Systems: Standard Soil Trenches ( ) or Bed ( ) Gravelless Pipe ( ), Diameter \_\_\_\_\_ In.  
Chamber Soil Absorption Trenches ( ☒ ) or Bed ( )  
Class II Systems: Pumped/Dosed Soil Absorption Trenches ( ) or Bed ( ) LPP ( )  
Evapotranspiration Trenches ( ) or Bed ( )  
Shallow Soil Absorption Trenches ( ) or Bed ( ) Other: \_\_\_\_\_

No. of Lines: 3 Length (in feet) of Each: 24 18, 80, \_\_\_\_\_  
Width of Trenches: 36 inches/feet Depth to Bottom of Field: 24 inches  
If Bed, Dimensions (in feet): \_\_\_\_\_ Size Equates to 1200 sq ft of SGF  
Distance (in feet) of System to: Dwelling 37  
Private ( ☒ ) Public ( ) Water Source: 122 Property Line: 10+  
Remarks: \_\_\_\_\_

GPS: N39 24 53.5 W78 31 57.6

An inspection indicates that  
The sewage disposal system  
Described above

DOES MEET ☒

DOES NOT MEET ☐ or

CANNOT BE DETERMINED TO


MEET ☐ the minimum standards  
Established by the West Virginia  
Bureau of Public Health.

To correct a health hazard,  
Modifications to existing systems  
May be done to improve part of a  
System. Such modifications may  
Not be able to be designated as  
a Does meet system since  
Inadequate information is known.

Although many factors  
Contribute to the successful  
Functioning of a sewage disposal  
System, this office recommends  
Water conservation and  
Maintaining an even usage of  
Water throughout the week.

Visit Date(s): 2/1/10

North

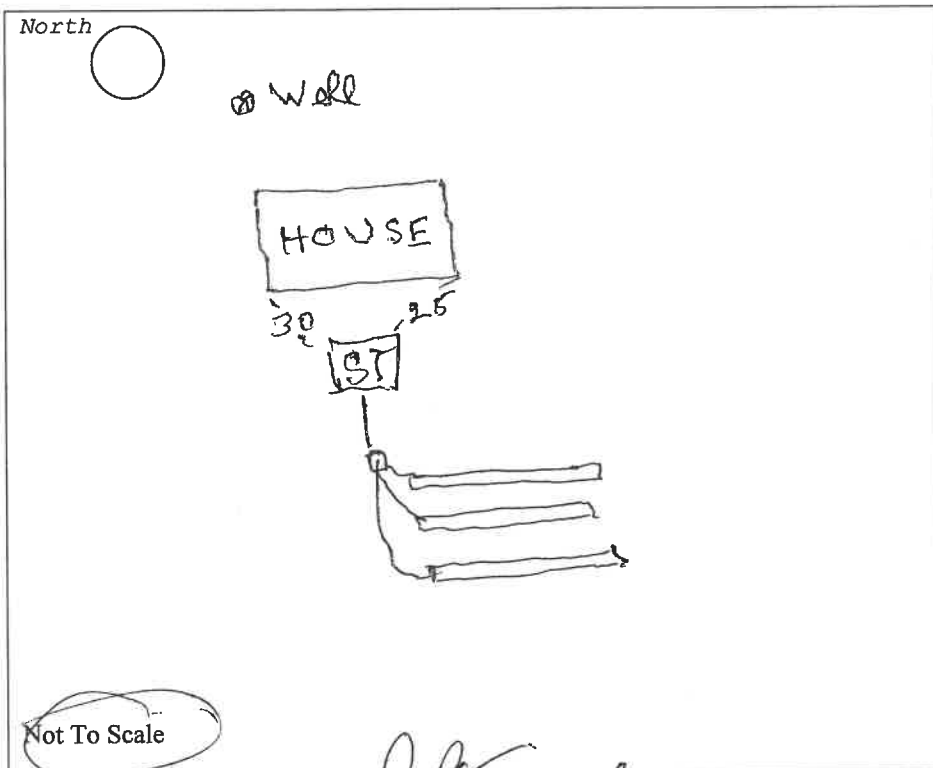

FINAL INSPECTION DATE: 4/5/2010

SANITARIAN: J. K. Kees