

WV STATE DEPARTMENT OF HEALTH
Office of Environmental Health Services
ENVIRONMENTAL ENGINEERING DIVISION

SW258

WELL COMPLETION REPORT

Patton Subd Lot 5

Date(s) 6/22/00 County Hampshire Permit #: DW-14-00-000 ⁰⁰⁻³⁴⁵
Town: Augusta Area Name/Location Martinsburg Road
Well Owner: Mike Carlin Address: P. O. Box 267-04
Telephone Number: 496-9929 Augusta, WV 26704
Well Driller: Jeffrey G. Miller Address: P. O. Box 412
Telephone Number: 496-9972 Shanks, WV 26761

WELL LOG

DEPTH IN FEET	FORMATIONS: KIND, THICKNESS, AND IF WATER BEARING	REMARKS:
0-2	Lt. Red Clay	Type of Well: <u>D/W</u> Drilling Method: <u>Air Percussion</u>
2-4	Lt. Brown Dirt	Well Diameter: <u>6 1/4"</u> Casing O.D.: <u>6 5/8"</u>
4-14	Lt. Red Clay	Well Depth: <u>100</u> Date Completed: <u>6/22/00</u>
14-18	Lt. Brown Shale	CASING: Length <u>40</u> Feet Height above ground <u>1</u> Feet
18-37	Lt. Blue Shale	☒ Steel ☐ Plastic ☐ Cast Iron
37-92	Lt. Blue Sandstone	Other _____ Type _____
2-100	Red Sandstone	
		SCREEN
		☒ None Installed
		Type _____ Diameter _____
		Slot/Gauge _____ Length _____
		Set Between _____ Ft. and _____ Ft.

PUMPING OR BAILING TEST

DETAILS	#1	#2	#3
Static Water Level (Ft. Below Grade)	10		
Pumping Rate (GPM)	100		
Pumping Level (Ft. Below Grade)	98		
Duration of Test (In Hours)	2		
Recovery Time to Static Level (In Hours)	1		

WELL HEAD

Pitless Adapter: Type, Make, Etc. _____
Well Cap: Type, Make, Etc. _____
Well Seal: Type, Make, Etc. _____
Well Platform: _____
Length _____ Width _____ Thickness _____
Pressure Grouting
Grouting: ☒ Yes ☐ No
All Public Water Supplies must be grouted.

I hereby certify that this well was drilled and constructed under my supervision, in compliance with all requirements of the referenced permit, and that this record is true to the best of my knowledge and belief.

Jeffrey G. Miller

255

Name

Certification No.

Miller Bros. Drilling

Registered Business Name

Signed

6/26/00

Date

SS 172-7/00-

STATE OF WEST VIRGINIA

INSPECTION TO BE
PRINTED OR TYPED

HEALTH DEPARTMENT

Permit No.: ST-14-00-090County: HamPSWIRE **ON-SITE SEWAGE DISPOSAL SYSTEM
INSPECTION FORM**

Tax Map: _____ Parcel #: _____

County Road: _____

Name of Owner: M. A. C. CARLIN Installer: R. DAVIS
 Address: P.O. Box 94, Arfton, WV 26204
 Property Location: SWANNA 2 Rd Left of overwoods 3.2 miles on left
 Type of Facility: HOUSE Facility is: New () Existing () Lot Size: 3.03 Sq.-Ft./Acres
 Design Loading in gpd/No. Bedrooms: 3 BR Source of Water Supply: well

SEWAGE TANK COMPONENT

Capacity in Gallons: 1000 Material: CONCRETE Manufacturer: JOHNSON
 Distances (in feet) of Tank to: Dwelling: 34 Private (X)/Public () Water Source: 50' Property Line: 50'

ON-SITE DISPOSAL SYSTEM

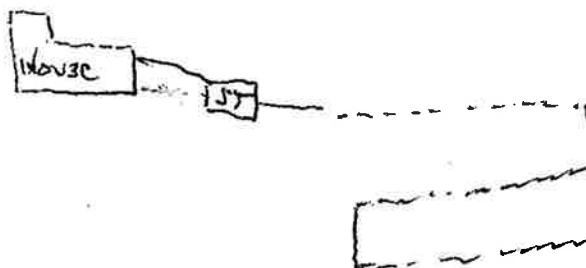
Class I Systems: Standard Soil Absorption Trenches () or Bed () Gravelless Pipe (X), Diameter: 10 Inches
 Chamber Soil Absorption Trenches () or Bed ()
 Class II Systems: Pumped/Dosed Soil Absorption Trenches () or Bed () Evapotranspiration Trenches () or Bed ()
 Shallow Soil Absorption Trenches () or Bed () Other: _____

No. of Lines: 3 Length (in feet) of Each: 100, 100, 100
 Width of Trenches: 24 inches/feet Depth to Bottom of Field: 24-36 inches
 If Bed, Dimensions (in Feet): _____ If Chamber System, Name: _____, No. of Units: _____
 Approved and Adequate Materials Used? Yes (X) No () Size Equates to: 700 Square Feet of Standard Gravel Field.
 Distances (in feet) of System to: Dwelling: 65' Private (X)/Public () Water Source: 100' Property Line: 50'
 marks: _____ to be

An inspection indicates that the sewage disposal system described above **DOES MEET (X)**, **DOES NOT MEET ()**, **CANNOT BE DETERMINED TO MEET ()** the minimum standards established by the West Virginia Bureau of Public Health.

To correct a health hazard, modifications to existing systems may be done to improve part of a system. Such modifications may not be able to be designated as a does meet system since inadequate information is known.

Although many factors contribute to the successful functioning of a sewage disposal system, this office recommends water conservation and maintaining an even usage of water throughout the week.

Sketch of Installation with Triangulation or Distance to Specific Landmarks:Draw Arrow
toward North11-4-99
No Well

Not to SCALE

Visit Date(s): 9-13-99
 Final Inspection Date: 11-4-99

Sanitarian: J. K. R. S.