

YADKIN COUNTY HEALTH DEPARTMENT

3130

(Septic Tank) Improvements Permit and Certificate of Completion

(Ground Absorption Sewage Disposal System - G.S. Chapter 130-Article 13C)

OWNER OR CONTRACTOR Dr. G. J. Robbins

DATE 4-7-77 PERMIT

LOCATION Shady Grove Rd. from Smithtown L. into subdivision NO. 1256
Lots 21 and 22 on R. about 1/10 mi. S.R. NO. _____

SUBDIVISION NAME _____ LOT NO. _____ SECTION OR BLOCK NO. _____

HOUSE ☒ MOBILE HOME ☐ BUSINESS ☐

NO. BEDROOMS 3 NO. BATHROOMS 2

GARBAGE DISPOSAL UNIT YES ☒ NO ☐

AUTO. DISHWASHER YES ☒ NO ☐

AUTO. WASH. MACHINE YES ☒ NO ☐

SITE SUITABLE YES ☒ NO ☐

SIZE OF TANK 1200 gal.


NITRIFICATION FIELD 900 equiv. sq. ft.

DEPTH OF STONE IN LINES: 24 in. level over pipe

WATER SUPPLY: Individual ☒ Public ☐

IMPROVEMENTS PERMIT BY Charles King, Jr.

LOT AREA _____

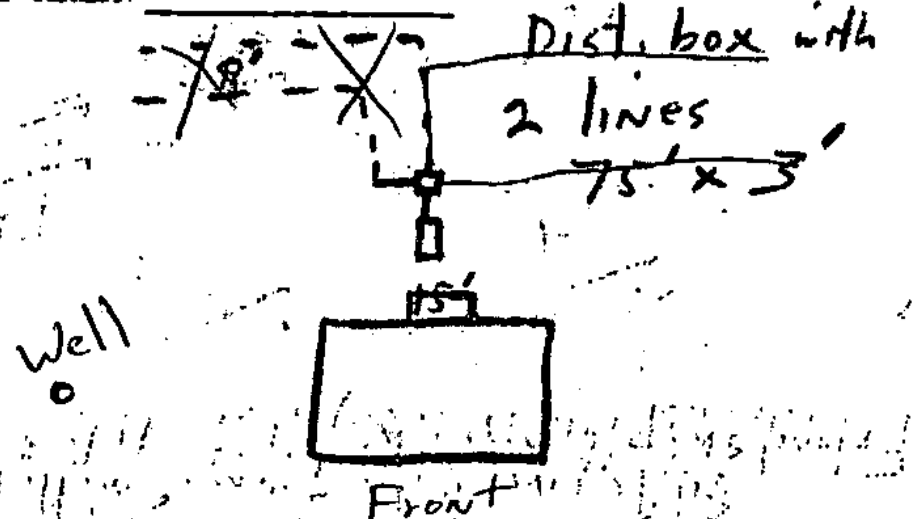

INSTALLED BY Keith Merritt (Stokes County)

CERTIFICATE OF COMPLETION

By Charles King, Jr.

Date 7-27-77

(8/16/73) *Construction must comply with all other applicable State and local regulations