

35272

WILKES COUNTY
COUNTY ENVIRONMENTAL HEALTH SECTION

Permit # 40337

OPERATION PERMIT

Expiration Date: _____

Types V and VI systems expire in 5 years.

Owner must contact Health Department

6 months prior to expiration, for permit renewal.

System Type: II

In accordance with table Va

Jennifer A. Koon

Applicant's Name

2204618


Subdivision / Section / Lot# / Property I.D. #

12/18/12

Date

Authorized State Agent

THIS SYSTEM HAS BEEN INSTALLED IN COMPLIANCE WITH APPLICABLE NORTH CAROLINA GENERAL STATUTES, RULES FOR SEWAGE TREATMENT AND DISPOSAL, AND ALL CONDITIONS OF THE IMPROVEMENT PERMIT AND CONSTRUCTION AUTHORIZATION. SYSTEM APPROVAL SHALL IN NO WAY BE TAKEN AS A GUARANTEE THAT THE SYSTEM WILL FUNCTION PROPERLY FOR ANY GIVEN PERIOD OF TIME.

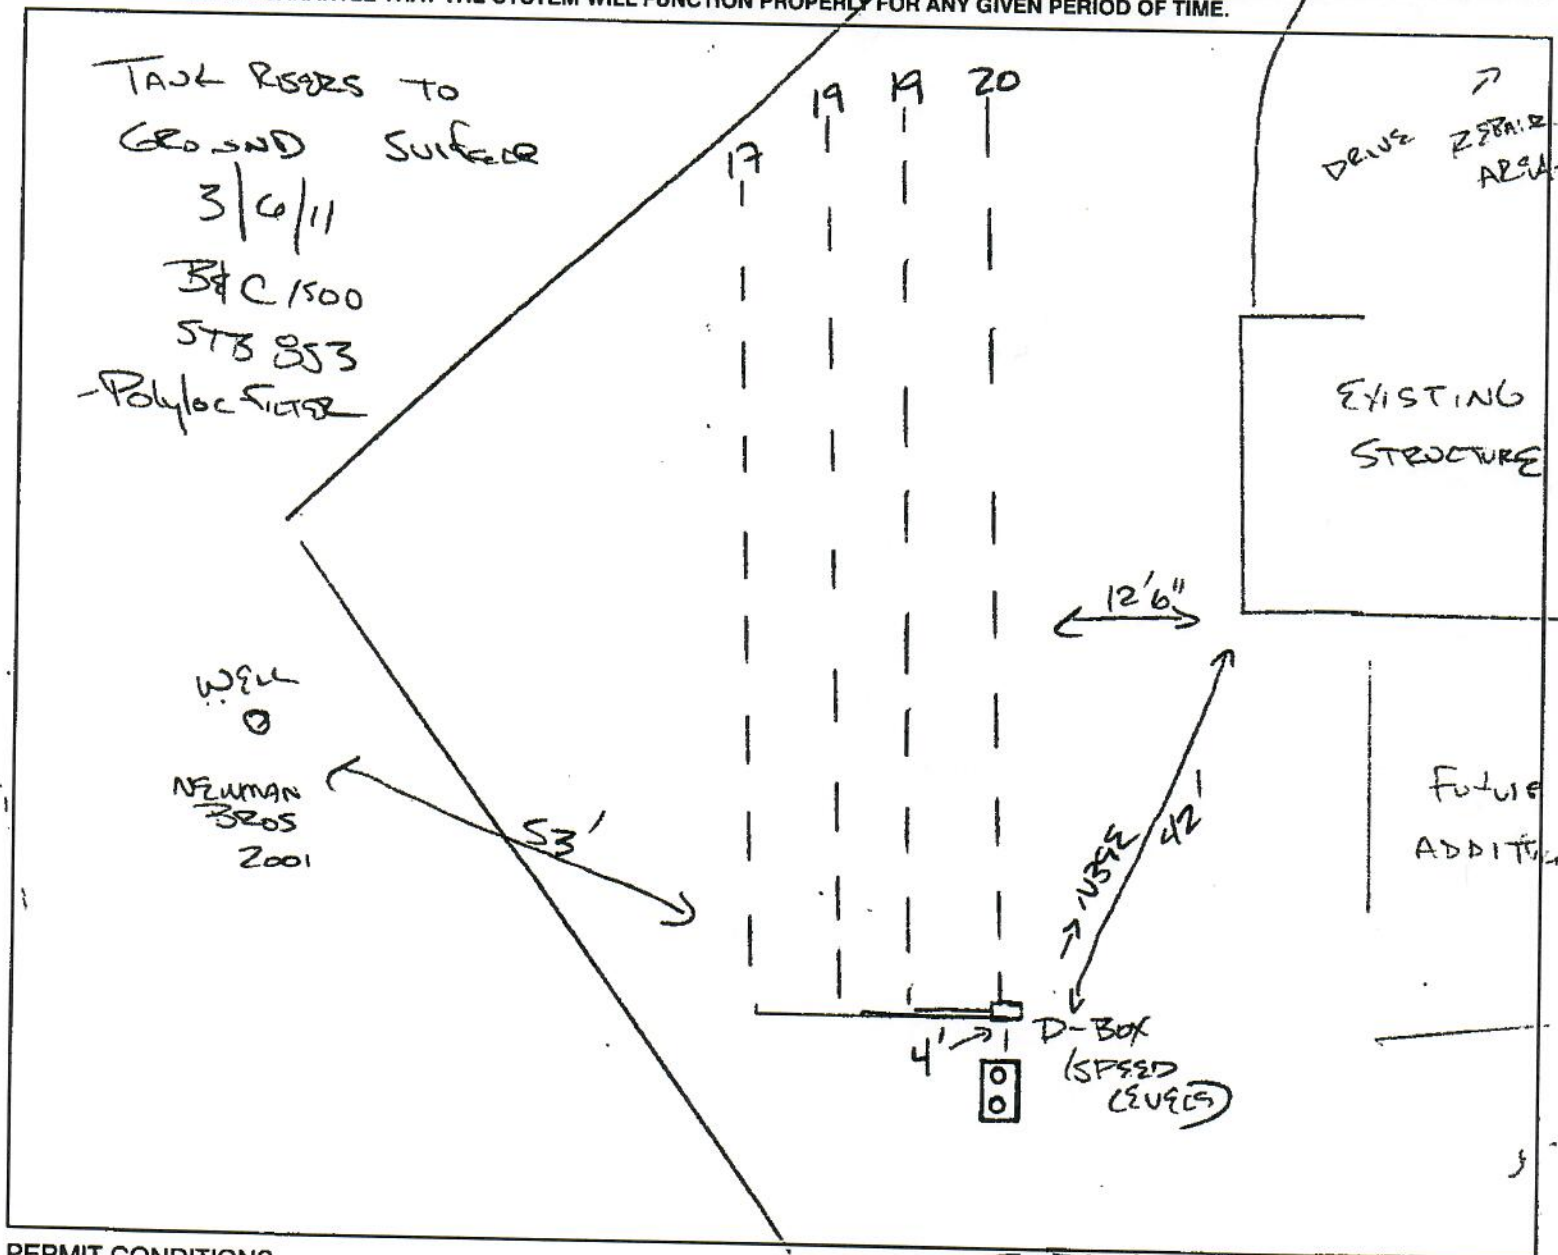

PERMIT CONDITIONS

I. Performance: System shall perform in accordance with Rule .1961

II. Monitoring: As required by Rule .1961

III. Maintenance: By owner, recommended pump up every 5 years

Subsurface system operator required? ☐ Yes ☒ No

If yes, see attached sheets for additional operation, conditions, maintenance, and repair.

IV. Operation: _____

V. Other: _____

System installed by: Bart Mathis