SURVEY

ADDRESS: 1100 CR 4036, Kaufman County, Texas.

LEGAL: All that certain lot, tract or parcel of land situated within the Cyrenia Kenneda Survey, Abstract No. 263, Kaufman County, Texas, same being all of that tract of land conveyed to Luis Andres Campbell et ux, Macy Campbell in Volume 4835, Page 224, Official Public Records of Kaufman County, Texas, and all of that tract of land conveyed to Luis A. Campbell and Macy R. Campbell in Volume 5414, Page 423, Official Public Records of Kaufman County, Texas, and being more particularly described as follows:

BEGINNING at a 1 inch steel rod found for the northeasterly most corner of said Campbell tracts;

THENCE South 30 degrees 22 minutes 46 seconds East, with the east right-of-way of County Road No. 4031 (p.k.a. Old Kemp Highway), passing a 1/2 inch steel rod at 41.22 feet and "5244" capped steel rods found at 434.62 feet and 643.37 feet, in all 1283.48 feet to a point for corner;


THENCE South 89 degrees 53 minutes 03 seconds West, within the right-of-way of County Road No. 4036, 932.73 feet to a point for corner;

THENCE South 89 degrees 36 minutes 13 seconds West, passing a 1/2 inch steel rod found at 25.51 feet to a point for corner;

THENCE South 89 degrees 25 minutes 47 seconds West, 1063.18 feet to a 1/2 inch steel rod found for corner;

THENCE South 89 degrees 59 minutes 54 seconds West, 1063.18 feet to a 3 1/2 inch fence post found for corner;

within the occupied road right-of-ways.

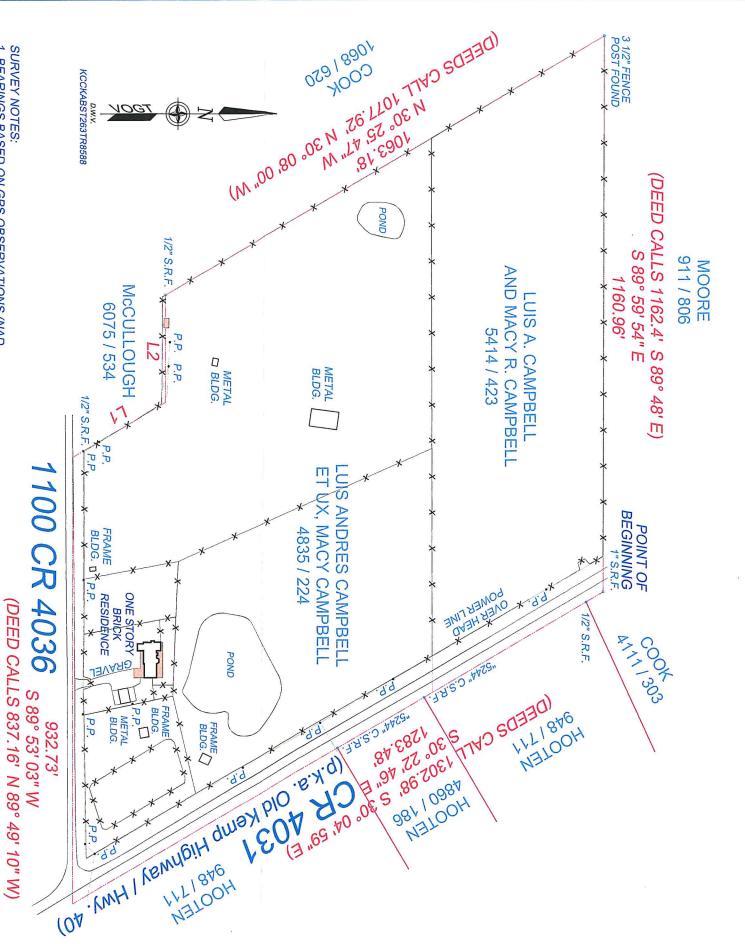

SURVEY NOTES:

1. BEARINGS BASED ON GPS OBSERVATIONS (NAD 83) HELD AS CONTROL.

2. ROAD R.O.W. FROM LONG TERM PUBLIC USE.

3. THIS PROPERTY IS COVERED BY THE FOLLOWING KAUFMAN - VAN ZANDT COUNTY SOIL CONSERVATION EASEMENTS: VOLUME 473, PAGE 136 R.P.R.K.C.T. AND VOLUME 537, PAGE 537, R.P.R.K.C.T. 4. THE FOLLOWING WATER LINE EASEMENTS ARE ALL 15 FEET WIDE AND CENTERED ON THE WATER LINES AS INSTALLED: VOLUME 595, PAGE 490, R.P.R.K.C.T., VOLUME 663, PAGE 832, R.P.R.K.C.T. AND VOLUME 5083, PAGE 322, O.P.R.K.C.T.

Date: 02-26-2020 Survey No.: 20.3860 Titlework by: Ranger Title G.F. No.: F200191K Scale: 1"=200' Seller: Campbell McCormick

LEGEND

Steel Rod Found Steel Rod Set Wood Fence Metal Fence S.R.F. S.R.S.

ANDREWS 1244 / 79

State Law (SEC 251.151) Requires anyone digging
deeper than 16 inches to
call the ONE-CALL
NOTIFICATION CENTER, two
days prior to digging.

LINE DATA L1 - 224.09' (DEED CALLS N 89° 48′ 00" W) (DEED CALLS N 30° 20' 17" W) L2 - 224.65' S 89° 54' 13" W N 30° 38' 04" W

The undersigned does hereby certify that this survey was this day made on the ground of the property legally described hereon and that there are no visible encroachments, overlapping of improvement, easements or rights-of-way, except as shown hereon and that said property appears to To: Ranger Title Company, Old Republic National Title, Synergy One Lending, Inc., Shawn D. McCormick: have access to a public roadw

to





5248

dvogtsurveying@yahoo.com Copyright 2020 Dennis Vogt Canton, Texas 75103 Phone (903) 865-1044 P.O. Box 852