

Certificate Of Completion

Forsyth County Health Department
Division Of Environmental Health And Laboratory
Post Office Box 686
Winston Salem, North Carolina 27102-0686
(910) 727-2760

Owner MITCHELL MASSENCUP
Address 6571 BETH-TABACCOVILLE
TOBACCOVILLE, N.C. 27050
E.H. Specialist STEVE BROWN

Use Of Structure: SINGLE FAMILY DWELLING

No. of Bedrooms: 3 Basement: Yes No 1

Water Supply: Well Public 1 Comm.

Subdivision Name: N/A

Business Information: No. of Employees No. of Seats

Total Square Footage: EXIST.

Septic Tank System Design: Septic Tank Size: 900 Gals.

Tank ID #

Installer: FRANK TRANSOU

New Installation Repair ADDITION


Drain field Design: LTAR 3

Total Trench Length: 200 Feet (see drawing)

Depth of Stone/Sand 12 Inches

Trench: Depth 24 Inches, Width 3 Feet

PIN# Code 6-2-93 Permit# 9415
APP# 604261 BLK # 4722 Lot# 53A
System Classification Type II
HOLD Approval Date 10-20-93

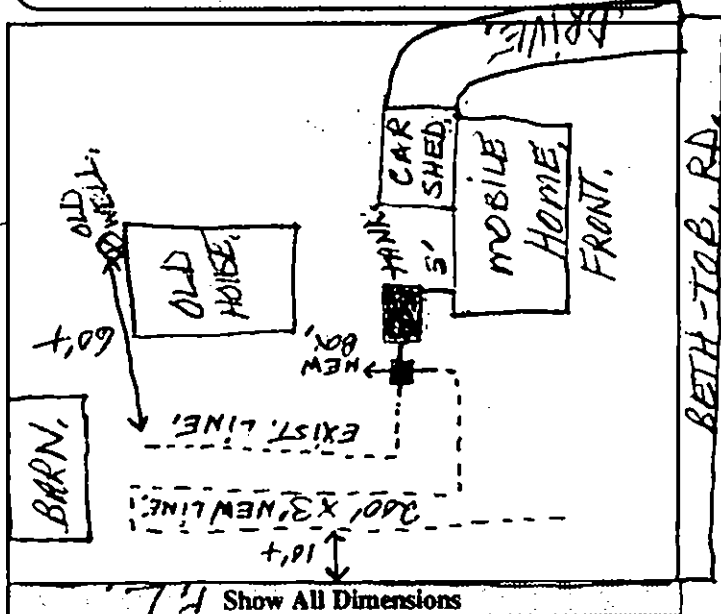

Location/Remarks: Hwy 52 N - exit 11 (Winston-Salem) T.L.
 then T.R. on right in P.O. Box 686 - 10 mi.
 P.O. Box 686 - 10 mi. on right at 6571