

Date 1/5/99 **YADKIN COUNTY HEALTH DEPARTMENT**  
Receipt # 15790 **ENVIRONMENTAL HEALTH SECTION**  
(910) 679-4244 No 013659

☐ Repair Permit ☒ Improvements Permit-5 Year ☐ Improvements Permit-WOE ☒ Authorization to Construct ☐ Well Permit

☒ Owner; ☐ Buyer; ☐ Agent: NAME Richard Church PIN # 5818-06-7465

Address [REDACTED] Sub-Division [REDACTED]

Phone: Home [REDACTED] Day [REDACTED] Sect. [REDACTED] Lot # [REDACTED]

State Road No. Rd. 157 Road Name 2 lots on left past Country Club Directions 601 N, TR Country Club

☐ In-City / 1 mile; ☐ 2 Mobile Homes on Property; ☐ County Zoned; ☐ Watershed III IV ☐ Plat Attached

**FACILITY**  
☒ House 3 Bedrooms ☒ Basement  
☐ Mobile Home 2 Baths ☒ Basement Bath  
☐ Church     Seats ☒ Garbage Disposal  
☐ Business     Employees     Other    

**WATER SUPPLY**  
    New ☒ Existing     Replacement  
    Private     Community     Public

Permit by     R.S. Date    

**SYSTEM SPECS**  
☒ New Installation     Repair Fall/100' Line = 0" LTAR:      
Tank Size 1200 gal. Max. Trench Depth 30"  
Linear Ft. 390 " Cover 18"  
Stone Depth 12" " No. Boxes 5 No. Lines 6  
System Type: conv. Class: PS  
Repair Type: conv. Class: PS  
Recommend # 5 stone


DESIGN

ACTUAL INSTALLATION

House  
site

TANK - 1200 gal.

Repair Area

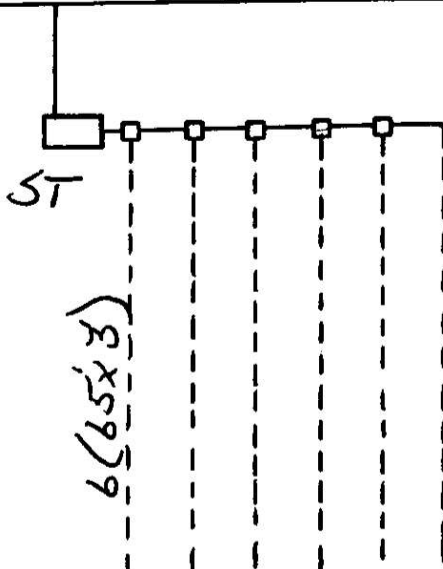

partial repair  
area

Installed By: JC Cohn

Requirements/Comments:    

★ Improvements Permit (NOT APPROVAL for building permit) By: Mike Williams R.S. Date: 2-11-99  
★ Authorization to Construct (APPROVAL for building permit) By: Mike Williams R.S. Date: 2-11-99  
★ Operation Permit (Conditions may be placed on OP) By: JMR R.S. Date: 8/31/99  
★ Authorization to Construct valid for 5 years. Any alteration of site may nullify improvements permit or authorization . . . they may be suspended or revoked upon a finding that a violation of Article 11 Chapter 130A, 1900 of Title 15A Subchapter of the N.C. Adm. Code, or a condition imposed upon the Improvements Permit or Authorization has occurred . . . also upon finding that issuance was based on incorrect or inadequate information. Form 97-F-2-JWCo