


Sketch Showing: Real property and visible improvements situated on Lots 5-12, Block 10, Norwood Addition, City of Eastland, Eastland County, Texas, according to the plat or map thereof recorded in Slide 80, Plat Cabinet Records, Eastland County, Texas, and being those same tracts of land described in deeds to Dale B. Spurlen, Trustee recorded in Instrument No. 2011-001984, Official Public Records, Eastland County, Texas, (Tract #2) and Eastland Machine & Welding, Inc. recorded in Vol. 1234, Pg. 137, of said Official Public Records.

Schedule B Notes: Property shown hereon sketch may be subject to the following items:  
10g. Easement to Eastland County Water Supply District recorded in Vol. 400, Pg. 262 DIRECT Does not apply.  
10h. Easement to Texas Electric Service Co. recorded in Vol. 562, Pg. 22 DIRECT (50' wide; as-built type easement; easement location is tied to the installed location of utility; may apply).

NORWOOD ADDITION,  
CITY OF EASTLAND,  
EASTLAND COUNTY, TEXAS

ACCORDING TO THE PLAT OR MAP THEREOF RECORDED IN  
SLIDE 80, PLAT CABINET RECORDS, EASTLAND COUNTY, TEXAS.

BLOCK 11

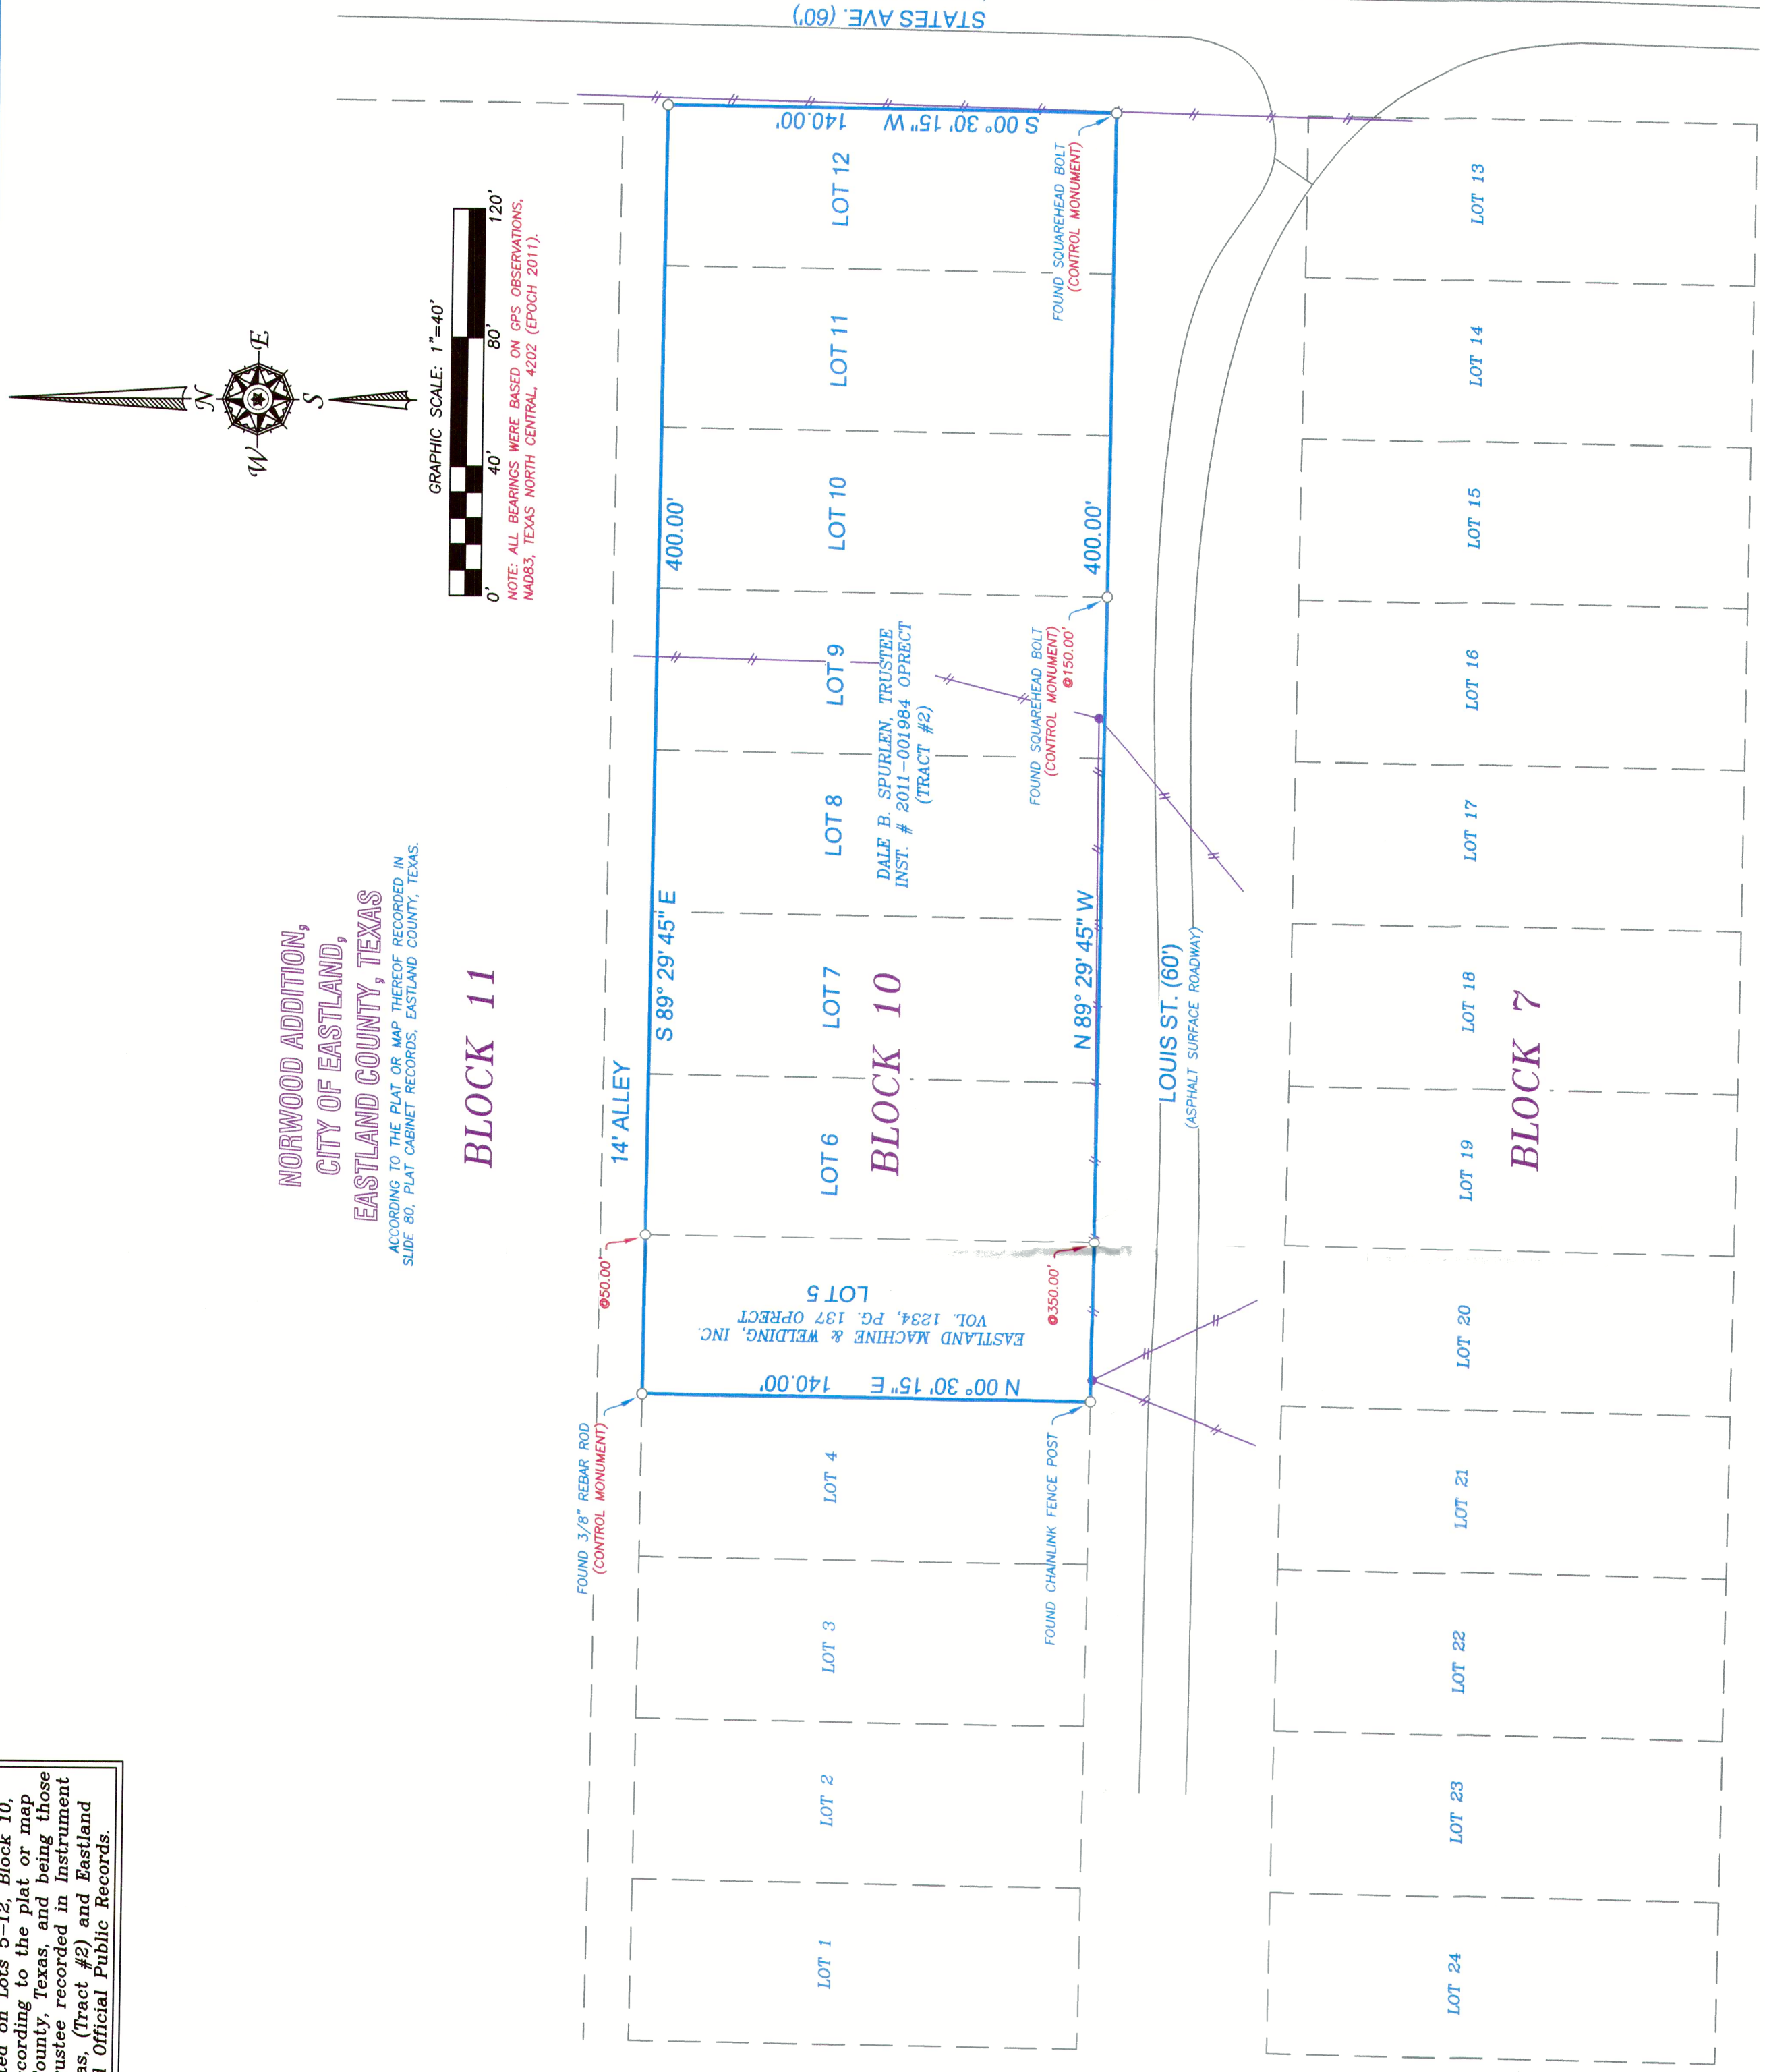

| LEGEND |                                                      |
|--------|------------------------------------------------------|
|        | SET 1/2" REBAR ROD WITH SURVEY CAP                   |
|        | STAMPED R.P.L.S. 6224; UNLESS OTHERWISE NOTED HEREON |
|        | GAS METER                                            |
|        | UTILITY POLE                                         |
|        | TELEPHONE PEDESTAL                                   |
|        | WATER METER                                          |
|        | DOWN GUY                                             |
|        | FENCE LINE                                           |
|        | OVERHEAD UTILITY LINE                                |
|        | EASEMENT LINE                                        |
|        | BUILDING LINE                                        |
|        | LOT LINE                                             |
|        | SURVEY LINE                                          |
|        | DESCRIBED TRACT                                      |
|        | COVERED AREA                                         |
|        | CONCRETE AREA                                        |



OFFICE (817) 650-0500 FAX (817) 650-0504  
EMAIL: info@arnold-land.com  
TRAP'S FROM NO. 101866-00

BDA/JOH GF# 221725 JOB# 2022-264



I, Barney Dan Arnold, Texas R.P.L.S. No. 6224, do hereby certify that this survey was made by me or under my direct supervision and conforms in all ways to the Texas Board of Land Surveying Minimum Standards, and there are no visible easements, overlaps or encroachments except as shown.

Copies are not official unless seal is embossed.  
Copyright Arnold Land Surveying & Mapping

09-14-2022