

WV Department of Health and Human Resources
Bureau for Public Health
Office of Environmental Health Services
ENVIRONMENTAL ENGINEERING DIVISION

SW258

WELL COMPLETION REPORT

Date(s) August 7, 2003 County Hampshire Permit # 04-14-03-212
Town: Mardonsville Area Name/Location River Ridge Lot # 11
Well Owner: Albena Investors, Inc. Address: 4338 Forest Lane NW
202-364-5100 Washington, DC 20007
Well Driller: Miller Bros. Drilling Address: P. O. Box 952
304-822-4092 Romney, WV 26757

WELL LOG

DEPTH IN FEET	FORMATIONS KIND, THICKNESS, AND IF WATER BEARING	REMARKS: <u>4" and 6 5/8" steel driveshafts</u>
<u>0 - 3</u>	<u>Loose boulders & sand</u>	Type of Well: <u>DW</u> Drilling Method: <u>Aic Rotary Hammer</u>
<u>3 - 15</u>	<u>Lt. brown sand</u>	Well Diameter: <u>6"</u> Casing O.D.: <u>6 5/8" & 4"</u>
<u>15 - 27</u>	<u>Lt. bluish sand - hard</u>	Well Depth: <u>350'</u> Date Completed: <u>August 7, 2003</u>
<u>27 - 37</u>	<u>Lt. brown sandst. - sandhard</u>	CASING: Length <u>20</u> Feet <u>6"</u> Height above ground <u>1</u> Feet
<u>37 - 50</u>	<u>Lt. blue ss, chunky - hard</u>	☒ Steel ☐ Plastic ☐ Cast Iron
<u>50 - 66</u>	<u>Good blue crystalline ss, hard</u>	Other _____ Type _____
<u>66</u>	<u>5" roller bit, bad formation</u>	
<u>66 - 160</u>	<u>brown sandstone, mostly sand</u>	SCREEN
<u>160 - 240</u>	<u>Whitish-blue sand & some stone</u>	☐ None Installed
<u>240 - 250</u>	<u>couple soft spots</u>	Type _____ Diameter <u>4"</u>
<u>250 - 338</u>	<u>good whitish ble ss, mostly sand</u>	Slow Gauge _____ Length <u>63'</u>
<u>338 - 350</u>	<u>turning darker brown ss, more rock</u>	Set Between <u>387</u> Ft. and <u>350</u> Ft.

PUMPING OR BAILING TEST

DETAILS	#1	#2	#3
Static Water Level (Ft. Below Grade)	<u>220</u>		
Pumping Rate (GPM)	<u>30</u>		
Pumping Level (Ft. Below Grade)	<u>348</u>		
Duration of Test (In Hours)	<u>2</u>		
Recovery Time to Static Level (In Hours)	<u>2</u>		

WELL HEAD

Pitless Adapter: Type, Make, Etc. Royer - Conduit type
Well Cap: Type, Make, Etc. _____
Well Seal: Type, Make, Etc. _____
Well Platform: _____
Length _____ Width _____ Thickness _____
Grouting: ☐ Yes ☐ No
All Public Water Supplies must be grouted.

I hereby certify that this well was drilled and constructed under my supervision, in compliance with all requirements of the referenced permit, and that this record is true to the best of my knowledge and belief.

Christopher O. Wolford

Miller Bros. Drilling

Registered Business Name

Signed

Certification No.

August 7, 2003

Date

INSPECTION TO BE
PRINTED OR TYPED

HAMPSHIRE COUNTY HEALTH DEPARTMENT

Permit No.: ST-14-03-274Tax Map: 14 Parcel #: 0011County: HAMPSHIRE

ON-SITE SEWAGE DISPOSAL SYSTEM

County Road: _____

INSPECTION FORM

Name of Owner: ALTONIA JAMES TON Installer: BILLY HART
 Address: 4338 FOREST LN NW WASHINGTON DC 20007
 Property Location: RIVER RIDGE SEC 2 LOT 11
 Type of Facility: RESIDENCE Facility is: New (☒) Existing () Lot Size: 25 Sq. Ft./Acres
 Design Loading in gpd/No. Bedrooms: 2 BR Source of Water Supply: WELL

SEWAGE TANK COMPONENT

Capacity in Gallons: 1000 Material: CONCRETE Manufacturer: TOLIN
 Distance (in feet) of Tank to: Dwelling: 19' Private (☒) Public () Water Source: 7100' Property Line: ~200'

ON-SITE DISPOSAL SYSTEM

Class I Systems: Standard Soil Absorption Trenches () or Bed () Gravelless Pipe (), Diameter: _____ Inches
 Chamber Soil Absorption Trenches (☒) or Bed ()
 Class II Systems: Pumped/Dosed Soil Absorption Trenches () or Bed () Evapotranspiration Trenches () or Bed ()
 Shallow Soil Absorption Trenches () or Bed () Other: _____


No of Lines: 3 Length (in feet) of Each: 48 54 78
 Width of Trenches: 36 inches/feet Depth to Bottom of Field: 24/34 inches
 If Bed, Dimensions (in Feet): _____ If Chamber System, Name: NEUTRATOR, No. of Units: 3
 Approved and Adequate Materials Used? Yes (☒) No () Size Equates to: 900 Square Feet of Standard Gravel Field.
 Distance (in feet) of System to: Dwelling: 150' Private (☒) Public () Water Source: 200' Property Line: ~200'
 Remarks: _____

An inspection indicates that the sewage disposal system described above **DOES MEET** (☒) **DOES NOT MEET** (), **CANNOT BE DETERMINED TO MEET** () the minimum standards established by the West Virginia Bureau of Public Health.

To correct a health hazard, modifications to existing systems may be done to improve part of a system. Such modifications may not be able to be designated as a **does meet** system since inadequate information is known.

Although many factors contribute to the successful functioning of a sewage disposal system, this office recommends water conservation and maintaining an even usage of water throughout the week.

Sketch of Installation with Triangulation or Distance to Specific Landmarks:

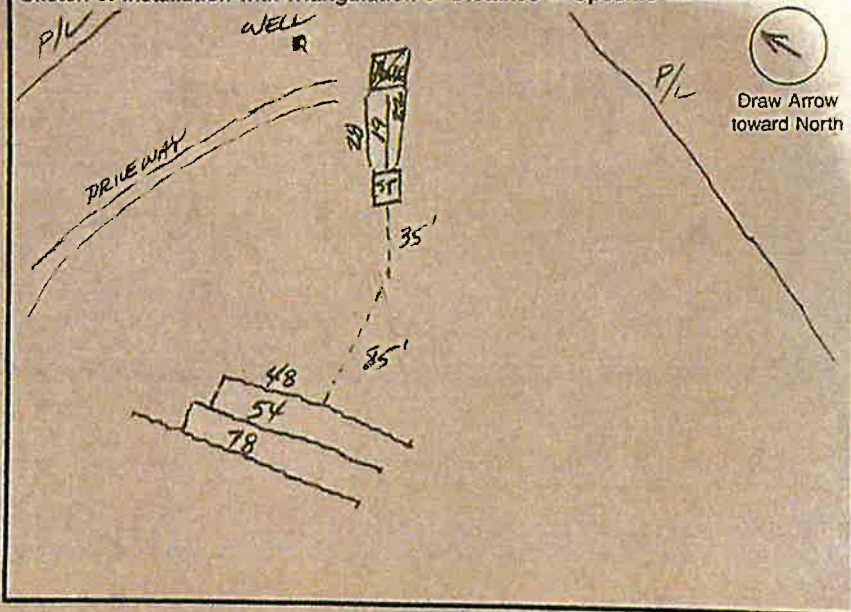

Visit Date(s) _____

Inspection Date: 8/12/03Sanitarian: [Signature]