

116092 F. J. M.

272-18


CLEVELAND COUNTY HEALTH DEPARTMENT
IMPROVEMENT PERMIT
315 Grover St., Shelby, NC 28150
(704) 484-5130

Owner / Agent Amanda Scism Property Address 3158 Ramseyer Ch. Rd Phone No. 704-538-0044
1811 6 4 Directions to property 226 N Pass Zion Ch. Rd
State Rd.# TwN# S/D-MHP Lot#
Intersection TR Ramseyer Ch. Rd. Prop 1 m on RT

Watershed Name First Branch Watershed Class _____ Critical Area: Y / N Acreage 259±

Valid without expiration () Valid for five years (☒)
(plat attached) (site plan attached)
Authorization to construct issued: Date 10/4/02
Single Family (☒) Multi-Family () House (☒)
MH () Business () Other _____
Water Supply: Public (☒) Private () Community ()
Slab () Crawl Space () Basement with plumbing (☒)
Basement without plumbing ()

New installation (☒) Repair ()
No. of Bedrooms 3 No. of residents 6 max design flow 360 gal/day
LTAR .35 Conventional System (☒) Pump to conventional ()
Alternative System () system type IIa conventional
Septic Tank 1000 gal. Pump tank _____ gal. Grease trap _____ gal.
Nitrification field 1028 sq. ft. No. of lines 4 Width 36"
Length 350' total Depth of gravel 12" max. trench bottom depth 30"
depth of cover 18" Repair area system type 10" large Diameter Pipe

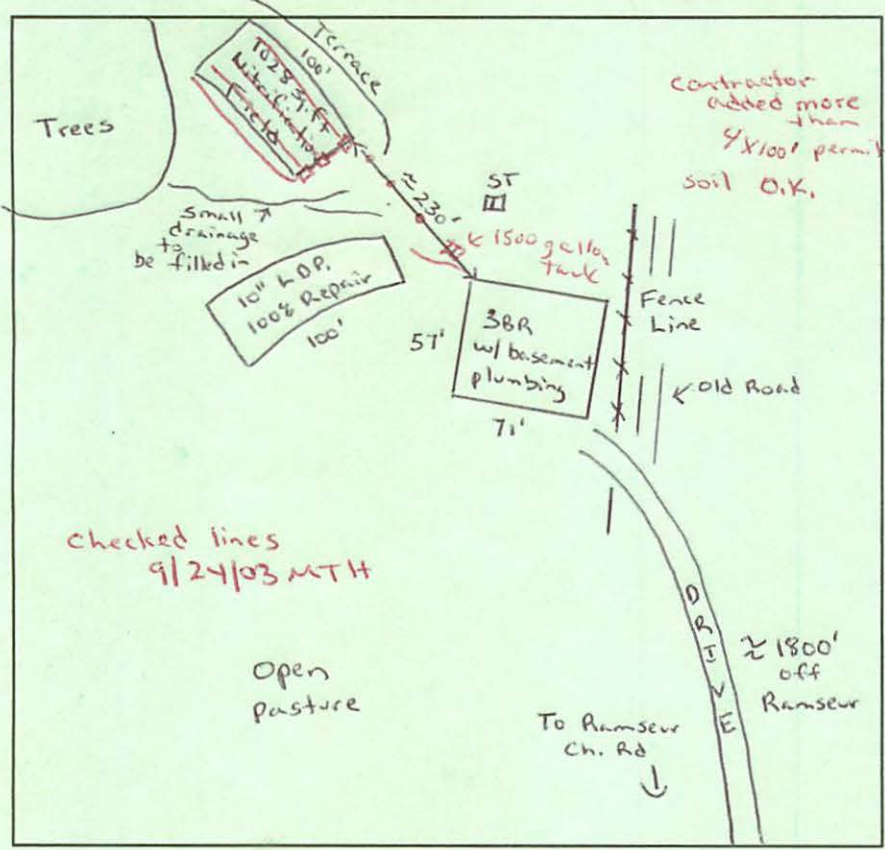

Operation Permit

System Classification _____ Insp. Freq _____
Contractor Leonard McSwain
Michael J. Daniel ES 9/24/03
Env. Health Specialist Date

This improvement permit shall be valid upon a showing to the Department that the site and soil conditions are unaltered, that the facility, design wastewater flow, and wastewater characteristics are not increased, and that a wastewater system can be installed that meets the permitting requirements in effect on the date the improvement permit was issued. Improvement permits for which a plat is provided shall be valid without expiration. Improvement permits for which a site plan is provided shall be valid for five years. This permit is subject to revocation if the site plan or plat, whichever is applicable, or the intended use changes.

The health department shall issue an authorization to construct prior to the installation or repair of wastewater system when it has determined after a field investigation that the system can be installed and operated in compliance with Article 11 of Chapter 130A of the general statutes of NC and Rules adopted pursuant to this Article. It will be valid for a period equal to the period of validity of the improvement permit, not to exceed five years.

Condition(s) of Issuance Install 350' of conventional system on contour no deeper than 30" max trench bottom Keep all parts of 10' off P/L waterline 5' off foundation Install according to all NC laws and regulations

Owner or Agent Amanda Scism Date 10-4-02 Environmental Health Specialist Michael J. Daniel ES Date 10/4/02