

Client(s): MICHAEL HASART
 26-111N-70
 27-111N-70W
 34-111N-70W
 35-111N-70W
 HAND COUNTY, SD


INVENTORY + AS-BUILT MAP

Scale: 1:16,000

NOTE- Location of tanks/pipeline/fence may have errors

Date: 9/16/2024

Assisted By: Jacey Goodale
 USDA-NRCS
 MILLER SERVICE CENTER
 HAND COUNTY CONSERVATION DISTRICT

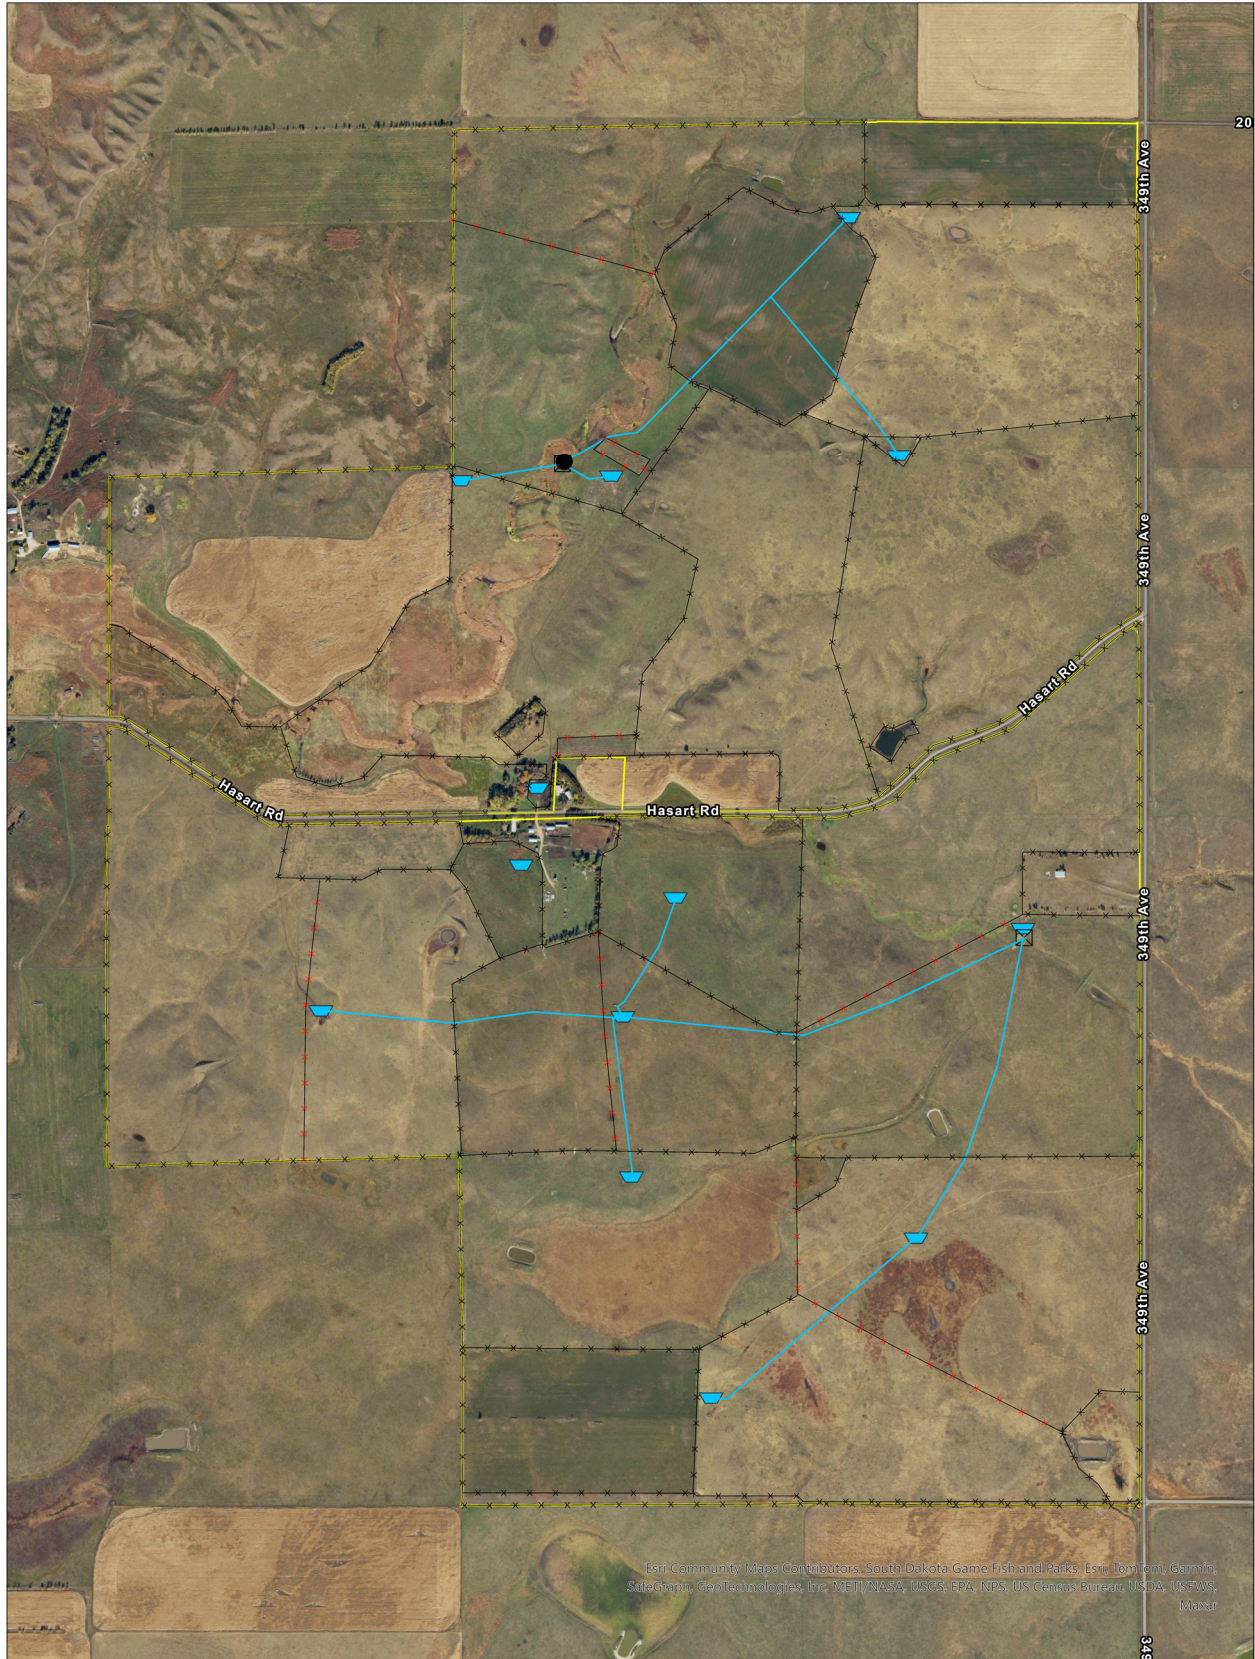

- Existing Fence
- NRCS Fence
- Livestock Pipeline

- ⊠ Pumping Plant
- ▤ Watering Facility
- ▭ Boundary Line

- Well



0 330 660 1,320
 US Feet

Prepared with assistance from USDA-Natural Resources Conservation Service