

Vacation
Bureau 7/15 11+12
See # 0301-1410


N.B.
See Page #6 for re-survey
of Pardo this time


11
Dorsetshire

Dispositive



Specified for German Police:
 1. Platz für den Polizisten (1)
 2. Platz für den Polizisten (1)
 3. Platz für den Polizisten (1)
 4. Platz für den Polizisten (1)
 5. Platz für den Polizisten (1)
 6. Platz für den Polizisten (1)
 7. Platz für den Polizisten (1)
 8. Platz für den Polizisten (1)
 9. Platz für den Polizisten (1)
 10. Platz für den Polizisten (1)

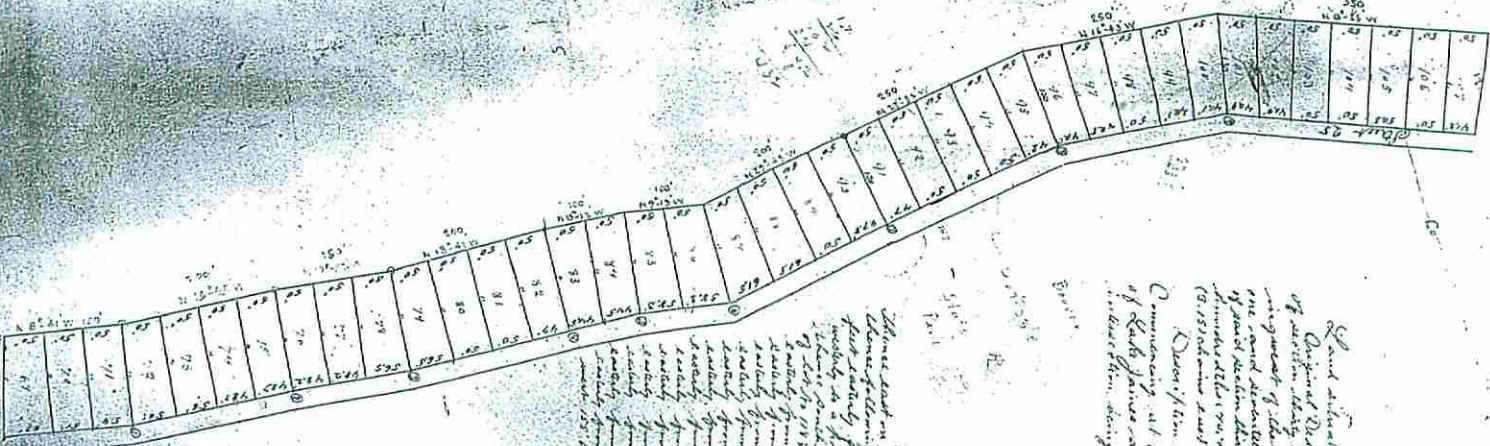

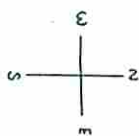

M. S. W. COR. LOT 53.
(1906) W. OAK (ORIGINAL) 12° N. 59° 30' W. 9.1'
SCALE 1" = 50'

Line between Sec. 34 and Twp. 37 N. R. 12 E. Sec. 33. Twp. 38 N. R. 12 E. of the 2nd P.M.



Noted Comment
 See Sec. 23 Pg. 457
 See Sec. 23 Pg. 45-5

Noted public ways
 See 76-03-06114

JOHN W. ORNDORF.

FIRST ADDITION
 to

LONE TREE POINT.
 - by J. W. Orndorf
 Civil Engineer

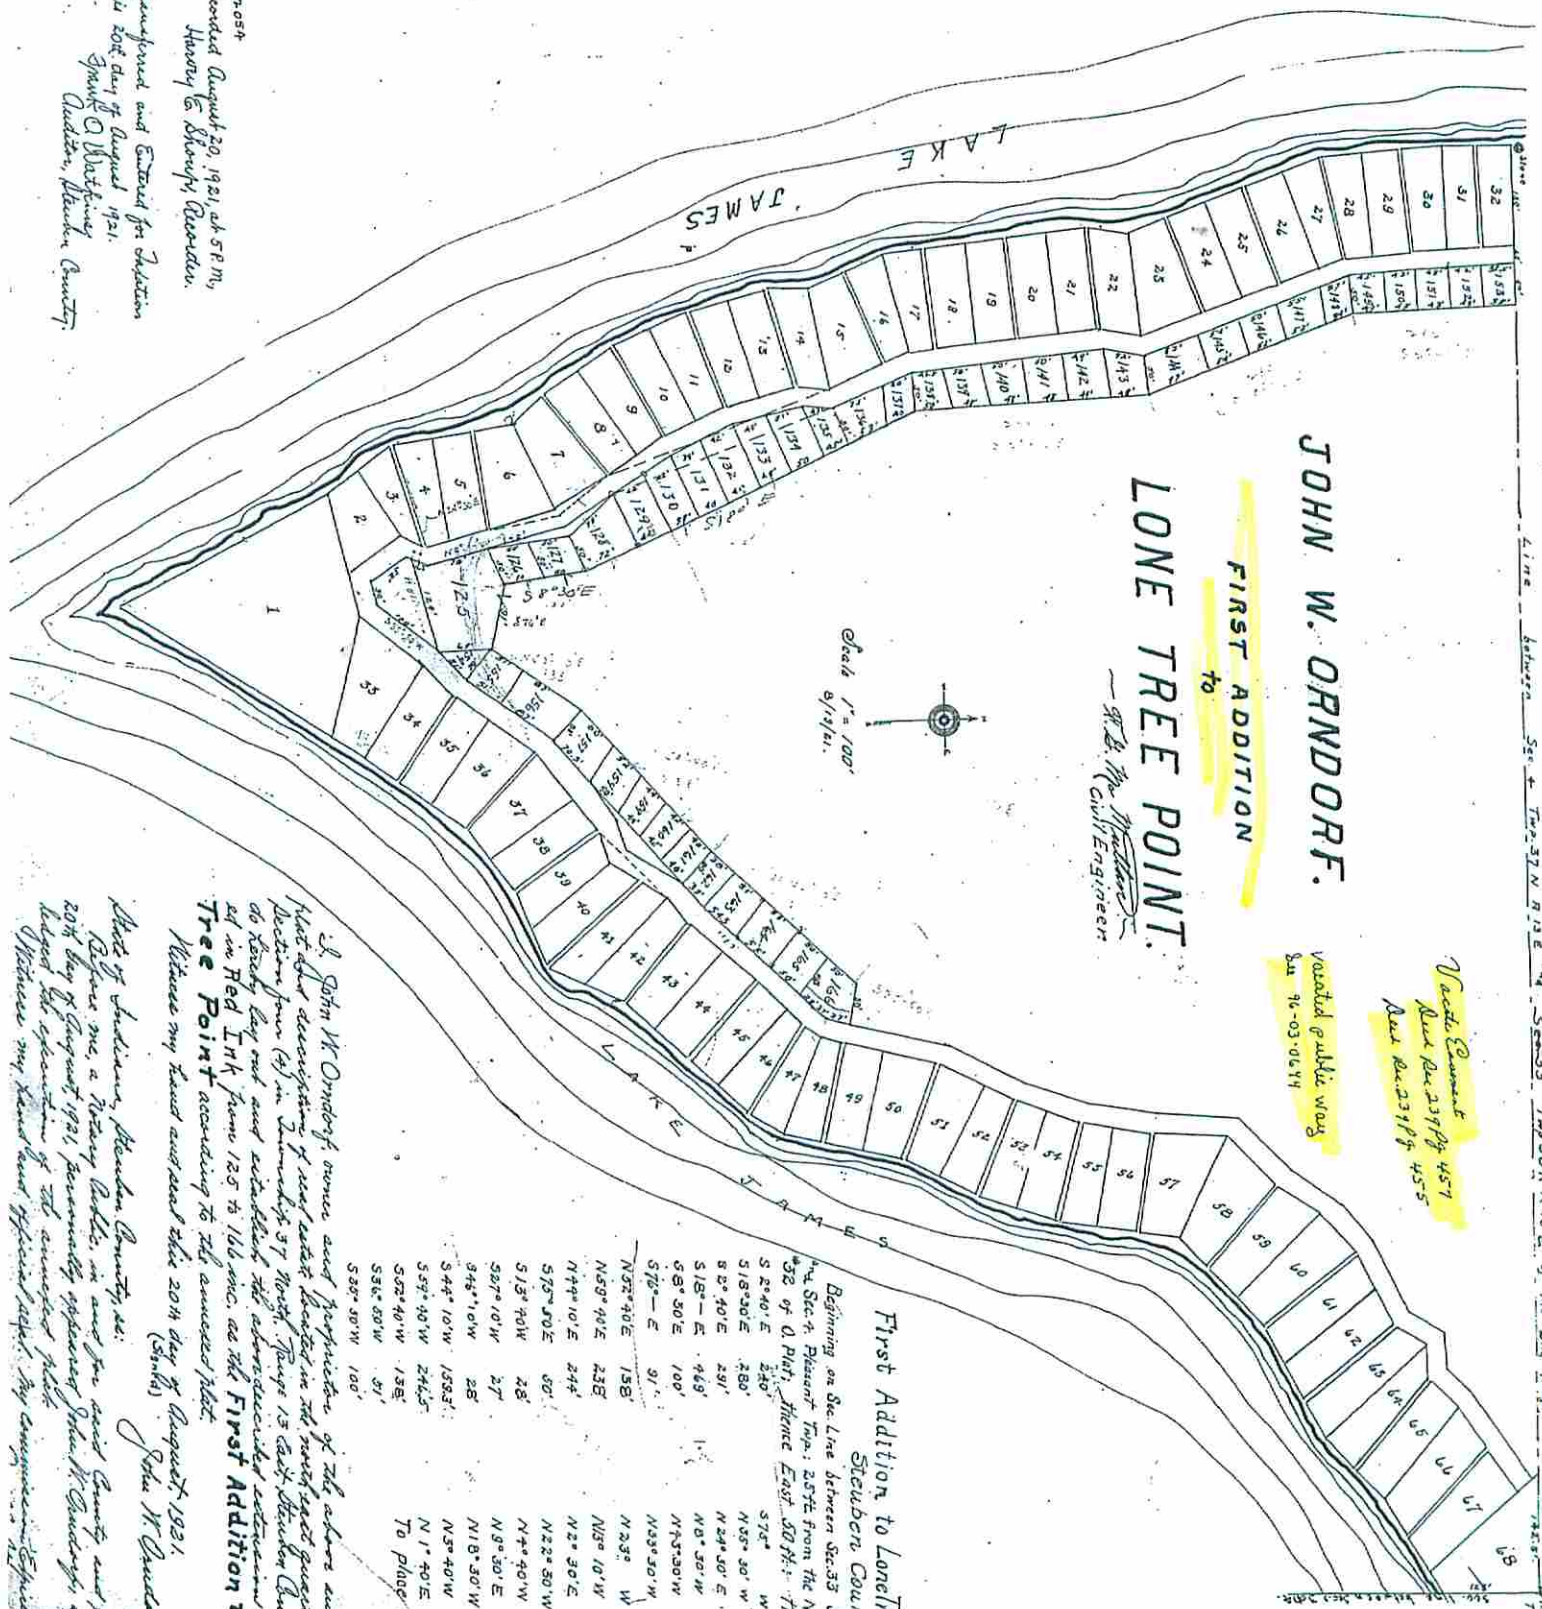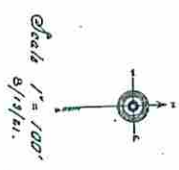

First Addition to Lone Tree Point,
 Steuben County, Ind.

Beginning on the line between Sec. 33 and Sec. 34, Pleasant Twp., 257 ft. from the N.E. cor. of Lot 32 of Q. Plat. Thence East 30 ft. Thence

S 2° 40' E 280'	S 76° W 20'
S 18° 30' E 280'	N 53° 30' W 52'
S 2° 40' E 291'	N 24° 30' E 27'
S 18° E 463'	N 0° 30' W 178'
S 8° 30' E 100'	N 75° 30' W 75'
S 70° E 91'	N 53° 30' W 84'
N 53° 40' E 158'	N 23° W 81'
N 53° 40' E 235'	N 5° 10' W 91'
N 74° 10' E 244'	N 2° 30' E 47'
S 75° 30' E 50'	N 22° 30' W 115'
S 13° 40' W 28'	N 7° 40' W 270'
S 87° 10' W 27'	N 8° 30' E 52'
S 44° 10' W 28'	N 18° 30' W 275'
S 44° 10' W 158.5'	N 5° 40' W 131'
S 57° 40' W 244.5'	N 1° 40' E 81.5'
S 52° 40' W 135'	To place of beginning
S 56° 50' W 31'	
S 38° 30' W 100'	

J. John W. Orndorf, owner and proprietor of the above and foregoing plat, after description of and under location in the first tract granted (14) of Section four (4) in Township 37 North, Range 13 East, Steuben County, Indiana, do hereby lay out and establish the above described sections the number of the Red Ink from 125 to 166 inc. as the **FIRST ADDITION to Lone Tree Point** according to the annexed plat.

Witness my hand and seal this 20th day of August, 1921.
 (Sigs) John W. Orndorf

State of Indiana, Steuben County, ss:

Before me, a Notary Public, in and for said County and State, this 20th day of August 1921, personally appeared John W. Orndorf, and whom I know to be the owner of the annexed plat, by comparison of the original plat with the copy hereof, and after reading of the original plat, he acknowledged to me that he executed the same for the purposes and to the effect therein expressed.

Recorded August 20, 1921, at 5 P.M.
 Henry G. Blaney, Recorder.
 Transferred and Entered for Station
 this 20th day of August 1921.
 Frank O. Wolfeney
 Auditor, Steuben County.