

YADKIN COUNTY ENVIRONMENTAL HEALTH SEPTIC SYSTEM LAYOUT FORM

☒ IMPROVEMENT PERMIT


☒ ATC

☒ OPERATION PERMIT

NAME Mark Coetzer DATE 03/07/13/OP 11/19/13
 ADDRESS 2733 Nebo Rd East Bend NC 27018
 PERMIT # 13070100324 LTAR 0.25

STS SPECS

NEW OR REPAIR <u>New</u>	SEPTIC TANK <u>1000</u>	TRENCH DEPTH <u>36"</u>
SYSTEM TYPE <u>Ha 25%</u>	PUMP TANK <u>—</u>	COVER DEPTH <u>24"</u>
REPAIR TYPE <u>Ha 25%</u>	LINEAR FT. <u>360</u>	STONE DEPTH <u>—</u>
INSTALLER <u>Tim Beeson</u>	NO. LINES <u>3</u>	SYS CLASS <u>Quik 4</u>

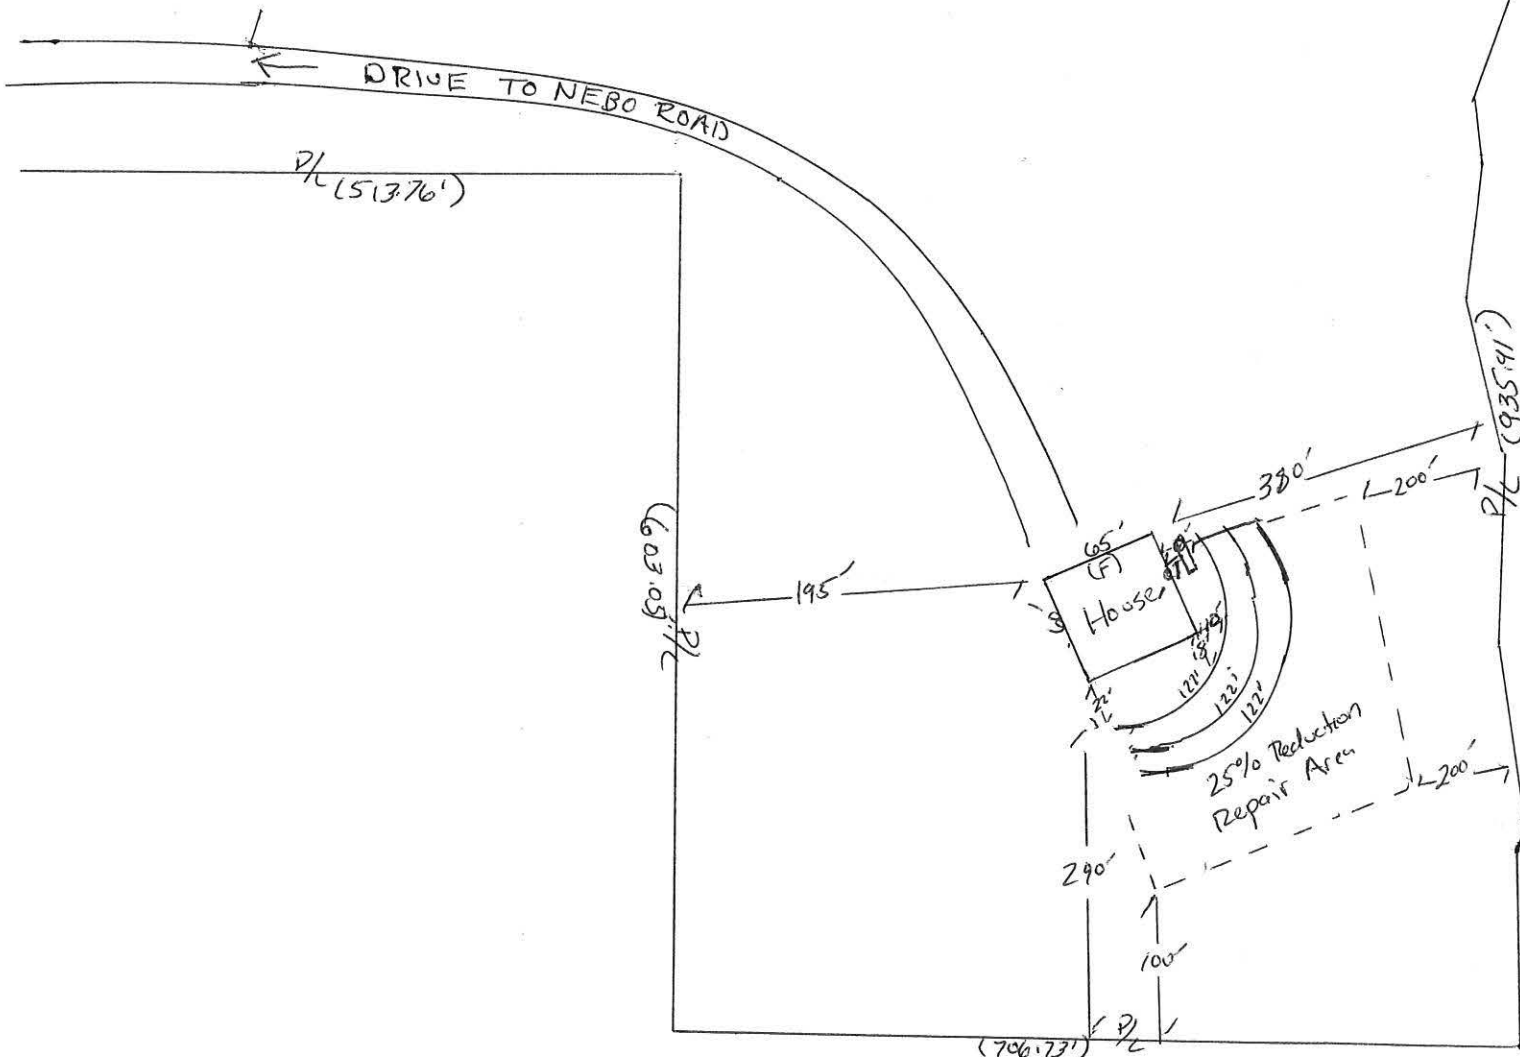

The issuance of this permit by the Health Department in no way guarantees the issuance of other permits. The permit holder is responsible for checking with appropriate governing bodies in meeting their requirements. This site is subject to revocation if the site plan, plat, or the intended use changes. The Improvement Permit shall not be affected by a change in ownership of the site. This permit is subject to compliance with the provisions of the Laws and Rules for Sewage Treatment and Disposal and to conditions of this permit.

This Construction Authorization is subject to revocation if the site plan, plat, or the intended use changes. The Construction Authorization shall not be transferred when there is a change in ownership of the site. This Construction Authorization is subject to compliance with the provisions of the Laws and Rules for Sewage Treatment and Disposal and to the conditions of this permit.

COMMENTS/CONDITIONS: No grading or fill in the septic or repair area.

BY: [Signature] REHS

Yadkin County Environmental Health

SOIL/SITE EVALUATION for ON-SITE WASTEWATER SYSTEM

OWNER: Mark Coetzer

PROPOSED FACILITY: 3 BR Home

PROPOSED DESIGN FLOW (.1949): _____

DATE EVALUATED: 03/04/13

LOCATION OF SITE: _____

PROPERTY SIZE: 27.76

WATER SUPPLY: ☒ Private ☐ Public ☐ Well ☐ Spring ☐ Other

PROPERTY RECORDED: _____

EVALUATION METHOD: ☒ Auger Boring ☐ Pit ☐ Cut

TYPE OF WASTEWATER: ☒ Sewage ☐ Industrial Process ☐ Mixed

P R O F I L E #	.1940 LANDSCAPE POSITION/ SLOPE %	HORIZON DEPTH (IN.)	SOIL MORPHOLOGY (.1941)		OTHER PROFILE FACTORS				PROFILE GLASS & LTAR
			.1941 STRUCTURE/ TEXTURE	.1941 CONSISTENCE/ MINERALOGY	.1942 SOIL WETNESS/ COLOR	.1943 SOIL DEPTH	.1956 SAPRO CLASS	.1944 RESTR HORIZ	
1	L 50%	0-12	SCL	fr gr SF	PS	PS	PS	PS	.25
		12-48	BC	fr w/WRKSE					
2	L 50%	0-8	SCL	fr gr SF	PS	PS	PS	PS	.25
		8-48	BC	fr w/WRKSE					
3	L 50%	0-24	C	fr. BLKSE	PS	PS	PS	PS	.25
		24-48	BC	fr w/WRKSE					
4									

DESCRIPTION	INITIAL SYSTEM	REPAIR SYSTEM	OTHER FACTORS (.1946): <u>PS</u> SITE CLASSIFICATION (.1948): <u>PS</u> EVALUATED BY: <u>Heath Snow</u> OTHER(S) PRESENT: _____
Available Space (.1945)	<u>PS</u>	<u>PS</u>	
System Type(s)	<u>25%</u>	<u>25%</u>	
Site LTAR	<u>.25</u>	<u>.25</u>	
COMMENTS:			