



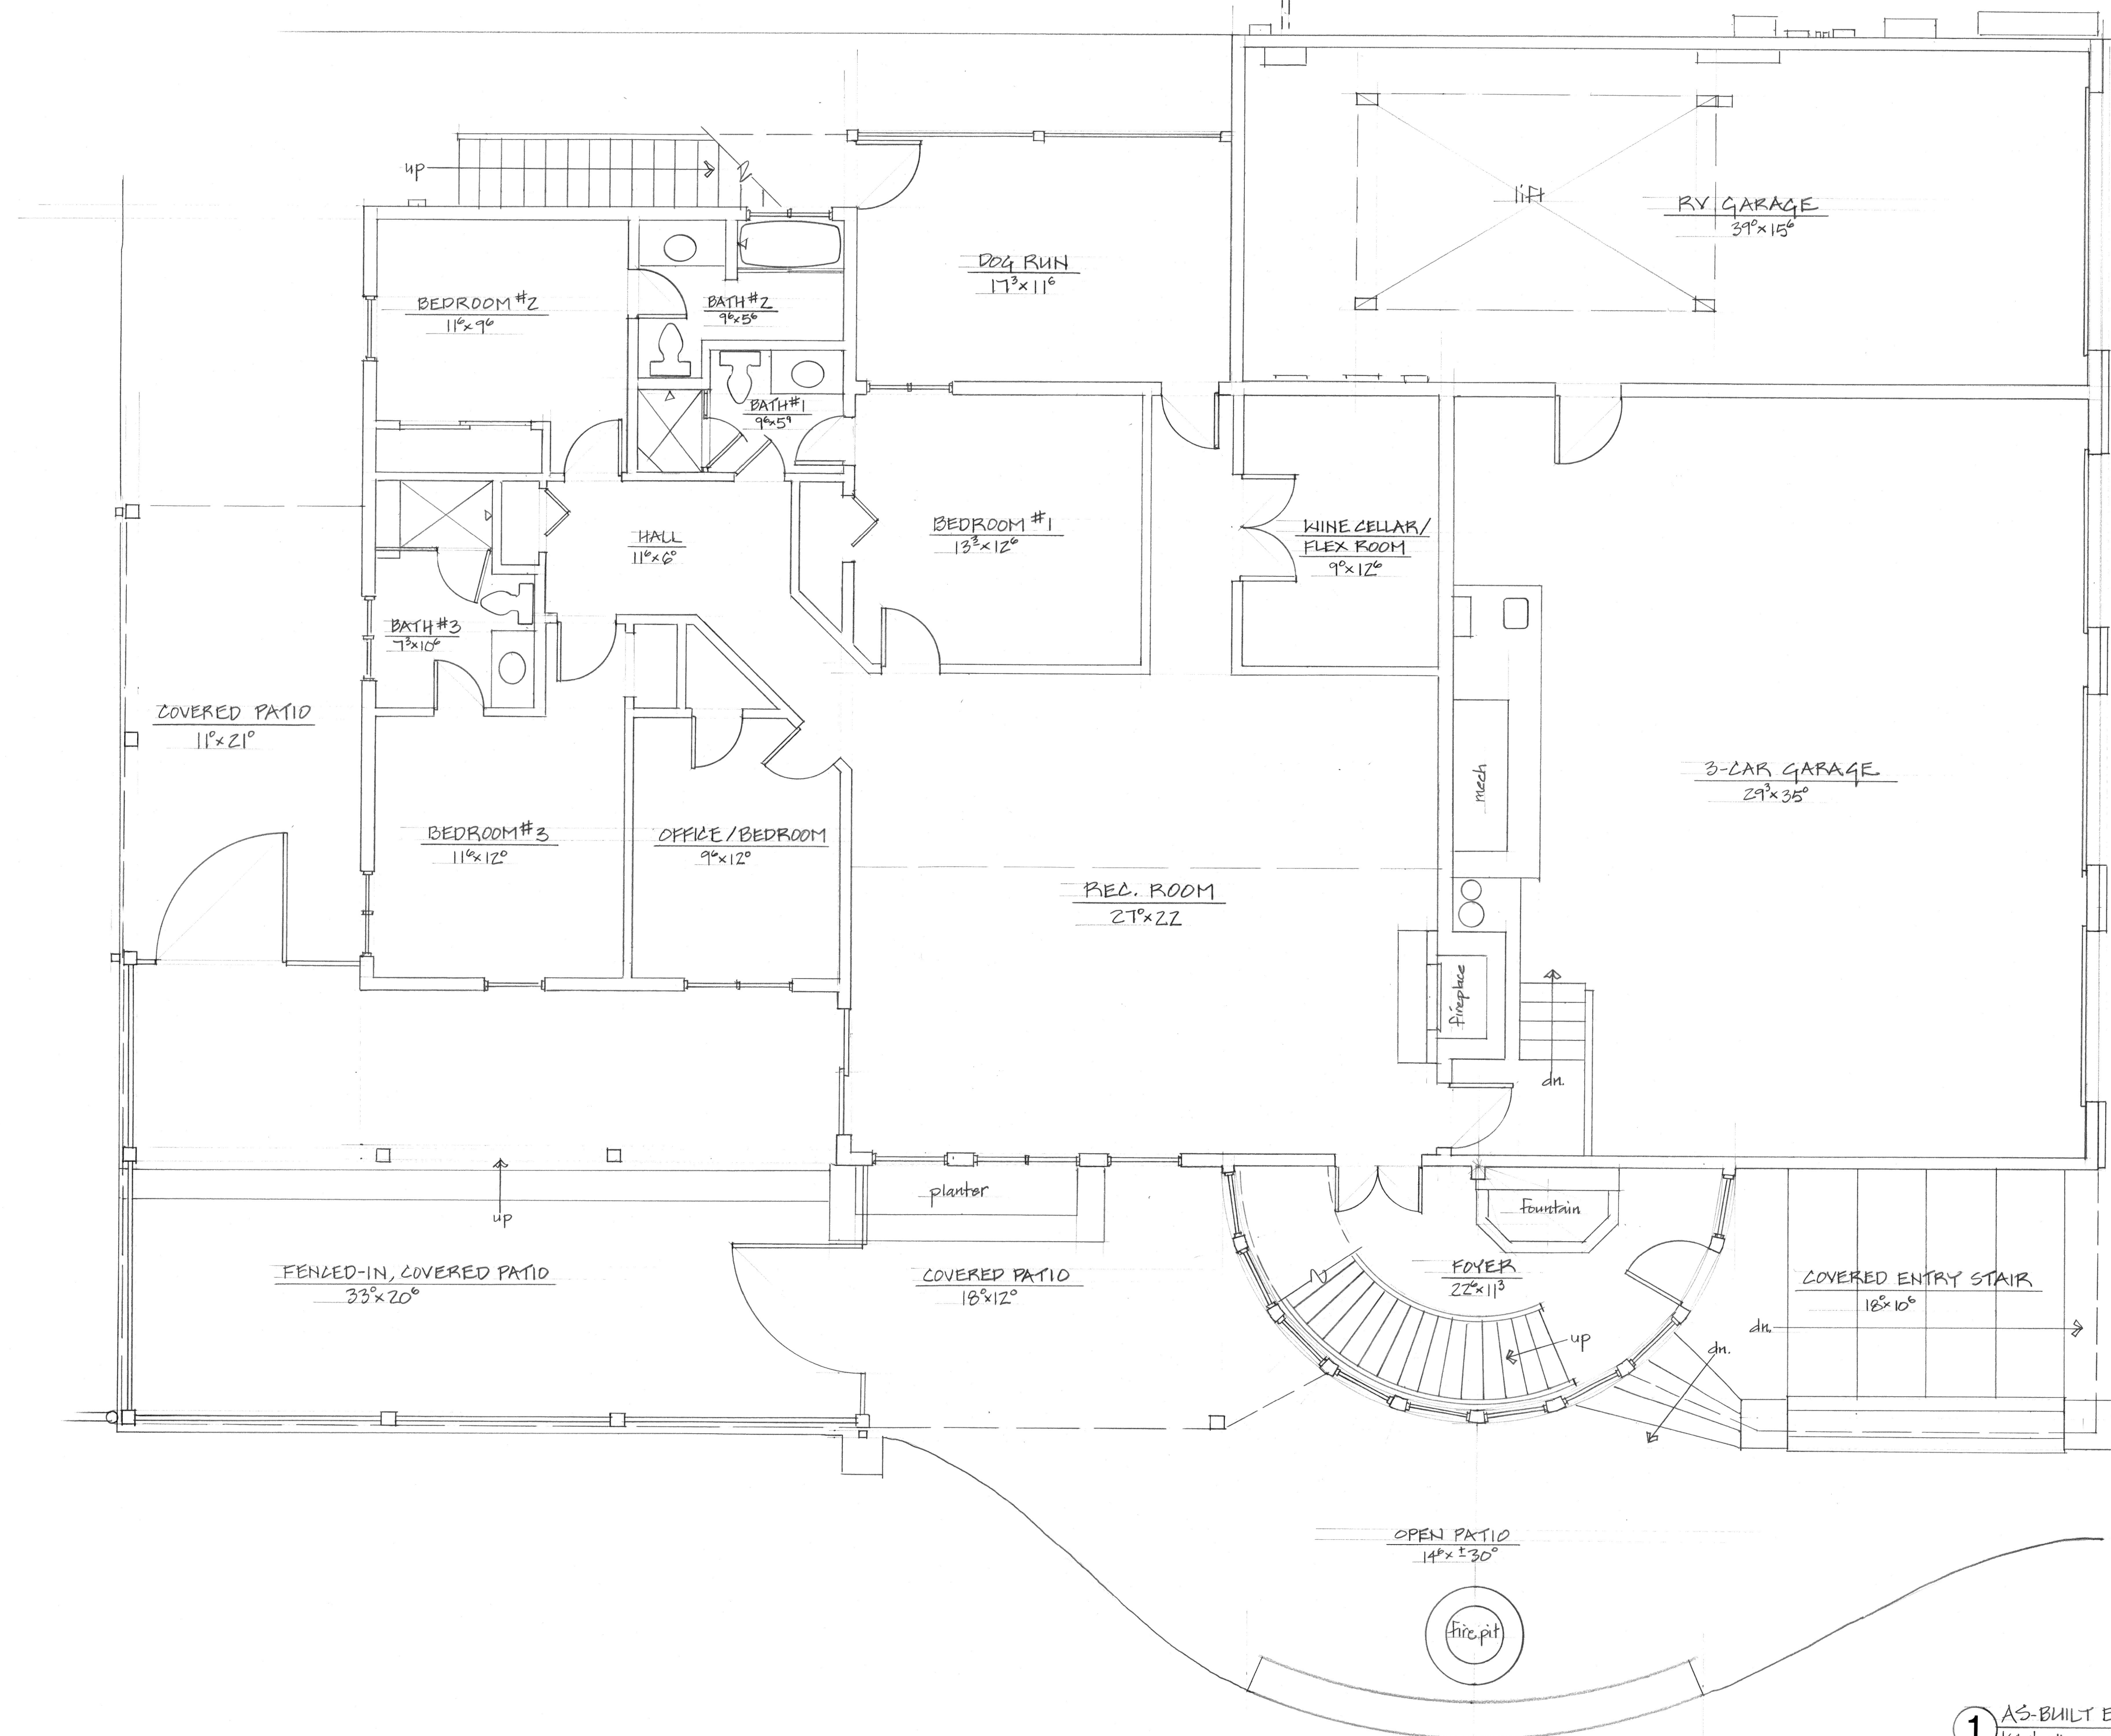

Upper Floor Living:	2883.7 #
Lower Floor Living:	2046.8 #
TOTAL LIVING:	4930.5 #
Garage Area:	1693.7 #
TOTAL BUILDING:	6624.2 #
Covered Patio:	1158 #
Dog Run:	203 #
Covered Deck:	1146.4 #
Open Deck:	418.8 #
Total Deck:	1565.2 #

1 AS-BUILT EXISTING LOWER FLOOR PLAN
1/4" = 1'-0"

REVISIONS: BY

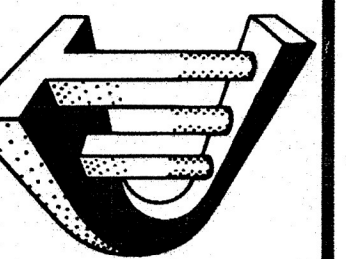

Thomas R. Chamberlain
ARCHITECT
14401 6215 Road
Montrose, Colorado 81403
970-240-7995 (Phone & Fax)

LICHTENBELT RESIDENCE


DRAWN BY
TRC
CHECKED

DATE
4-25-24
SCALE

JOB NUMBER


SHEET

A-1

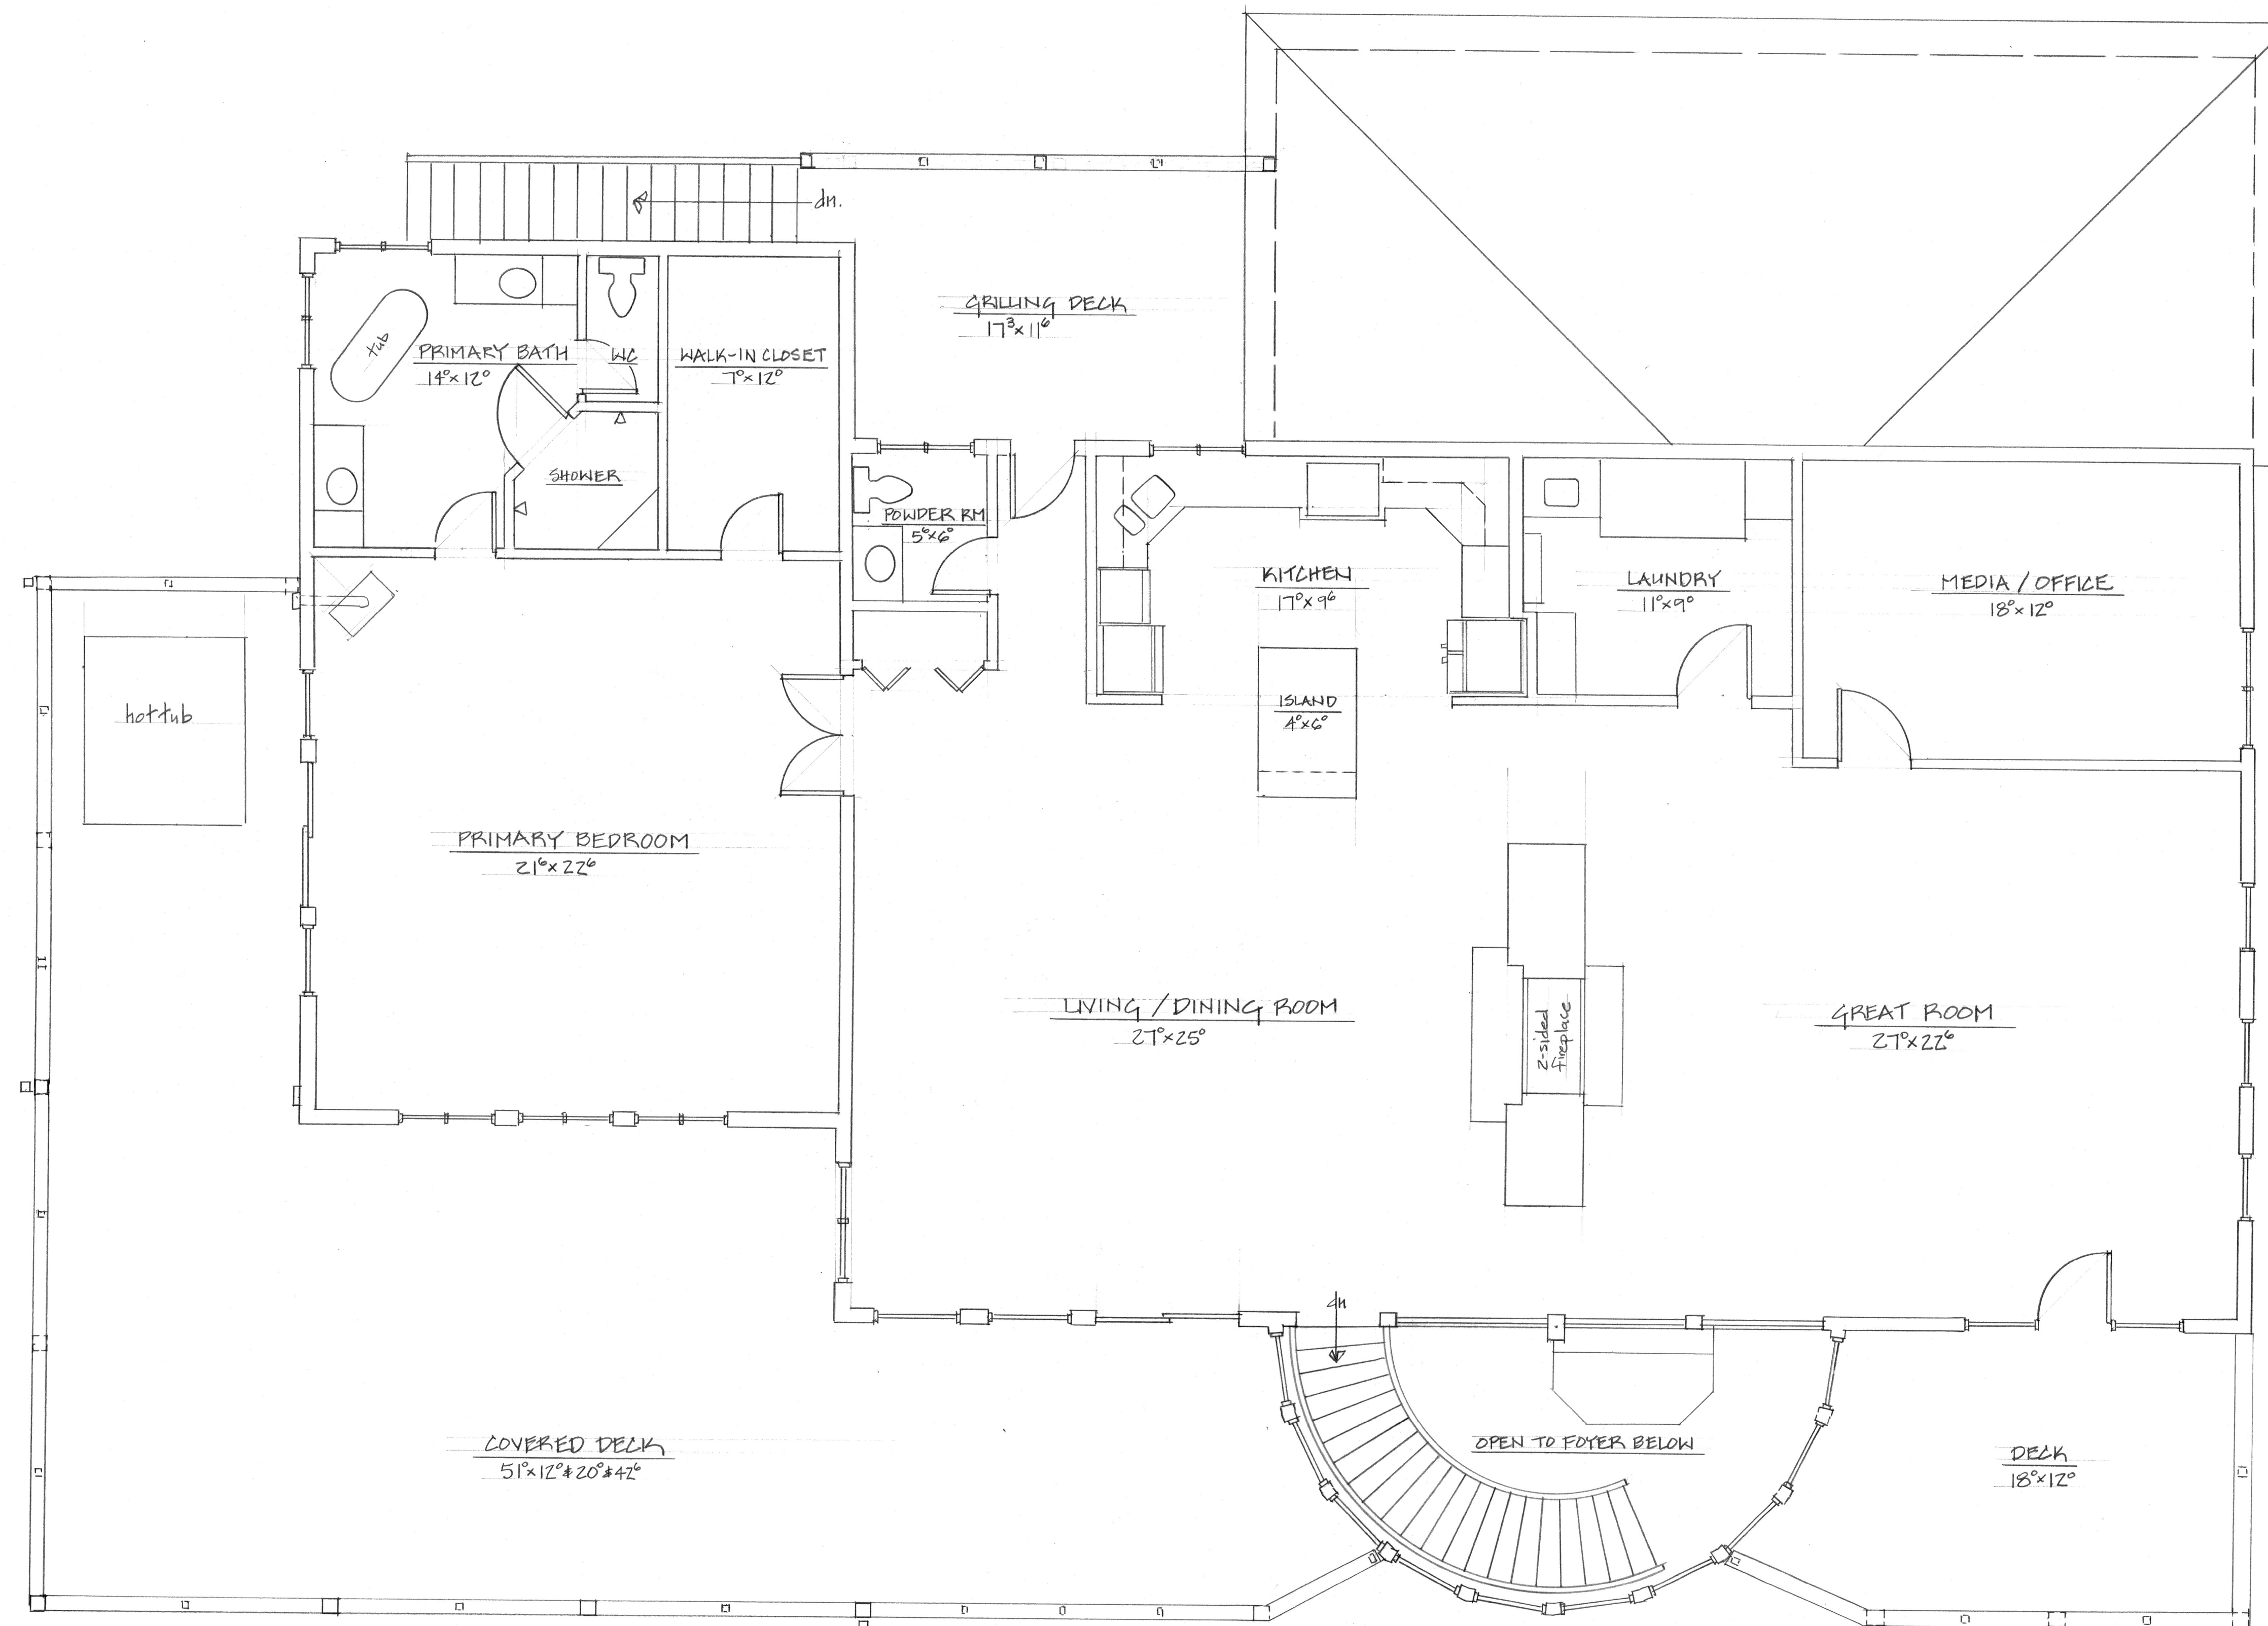

1 AS-BUILT EXISTING UPPER FLOOR PLAN
1/4" = 1'-0"

REVISIONS:	BY

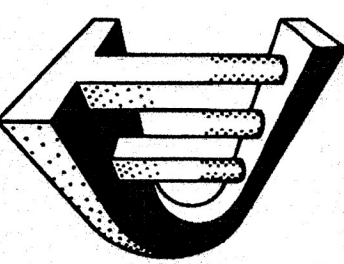

Thomas R. Chamberlain
ARCHITECT
14401 6215 Road
Montrose, Colorado 81403
970-240-7995 (Phone & Fax)

LICHTENBELT RESIDENCE

DRAWN BY
TFC
CHECKED
DATE
4-25-24
SCALE
JOB NUMBER
SHEET