

STATE OF WEST VIRGINIA

INSPECTION TO BE
PRINTED OR TYPED

Hampshire HEALTH DEPARTMENT
ON-SITE SEWAGE DISPOSAL SYSTEM
- INSPECTION FORM

Permit No.: ST-14-07-13
Tax Map: 7 Parcel #: 252
County Road: _____

County: Hampshire

Name of Owner: RICHARD & RUTH MODEL Installer: ELDRIDGE E. MORELAND
Address: 6340 BEECH LANE, HAYS LANDING, N.J. 08330
Property Location: SHARON KNOLLS LOT #6
Type of Facility: RESIDENCE Facility is: New ☒ Existing () Lot Size: 20 Sq. Ft./Acres
Design Loading in gpd/No. Bedrooms: 3 Source of Water Supply: WELL TO PL

SEWAGE TANK COMPONENT

Capacity in Gallons: 1000 Material: Concrete Manufacturer: _____
Distances (in feet) of Tank to: Dwelling: 100+ Private ☒ Public () Water Source: 150+ Property Line: _____

ON-SITE DISPOSAL SYSTEM

Class I Systems: Standard Soil Absorption Trenches () or Bed () Gravelless Pipe (), Diameter: _____ Inches
Chamber Soil Absorption Trenches ☒ or Bed ()
Class II Systems: Pumped/Dosed Soil Absorption Trenches () or Bed () Evapotranspiration Trenches () or Bed ()
Shallow Soil Absorption Trenches () or Bed () Other: _____

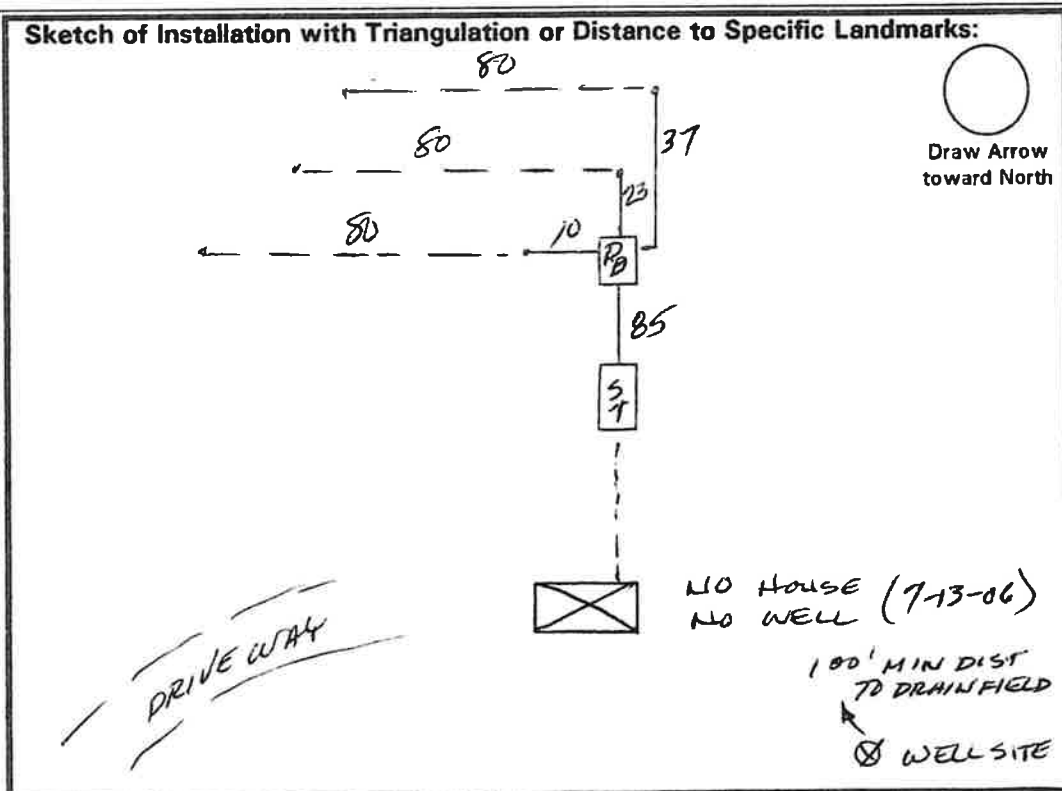
No. of Lines: 3 Length (in feet) of Each: 80, 80, 80, _____, _____, _____
Width of Trenches: 3 inches/feet Depth to Bottom of Field: 24 inches
If Bed, Dimensions (in Feet): _____ If Chamber System, Name: _____, No. of Units: _____
Approved and Adequate Materials Used? Yes ☒ No () Size Equates to: 1200 Square Feet of Standard Gravel Field.
Distances (in feet) of System to: Dwelling: 130+ Private ☒ Public () Water Source: 200+ Property Line: _____
Remarks: _____

An inspection indicates that the sewage disposal system described above
DOES MEET ☒
DOES NOT MEET (),
CANNOT BE DETERMINED TO MEET () the minimum standards established by the West Virginia Bureau of Public Health.

To correct a health hazard, modifications to existing systems may be done to improve part of a system. Such modifications may not be able to be designated as a does meet system since inadequate information is known.

Although many factors contribute to the successful functioning of a sewage disposal system, this office recommends water conservation and maintaining an even usage of water throughout the week.

Sketch of Installation with Triangulation or Distance to Specific Landmarks:

Visit Date(s): 7-6-06Final Inspection Date: 7-13-06Sanitarian: D. White