SW258

WV STATE DEPARTMENT OF HEALTH
Office of Environmental Health Services
ENVIRONMENTAL ENGINEERING DIVISION

WELL COMPLETION REPORT

Date(s) 6/27/91 - 6/27/91 County Hampshire Permit #: DW-14-06-91-284

Town: Slonesville WVa Area Name/Location Off Frank Horn Rd. in Cider Grove Estates Lot 58

Well Owner: John F Boose Address: 302 Dobson Dr Westminster Md 21157

Telephone Number: no

Well Driller: Melvin O Collis Address: P.O. Box 543 Slonesville WVa 25444

Telephone Number: 304-496-9947

WELL LOG

DEPTH IN FEET	FORMATIONS: KIND, THICKNESS, AND IF WATER BEARING
1 - 10 ft	Yellow Shale
10 - 100 ft	Lime Stone
Set 20 ft	Casing
100 - 200 ft	Lime Stone
200 ft	2 Gal mm
200 - 305 ft	Lime Stone

REMARKS:

Type of Well: D/W Drilling Method: Rotary Hammer

Well Diameter: 6 1/8 Casing O.D.: 6 5/8

Well Depth: 305 Date Completed: 7/10/91

CASING: Length 20 Feet Height above ground 1 Feet

☒ Steel ☐ Plastic ☐ Cast Iron

Other _____ Type

SCREEN

☒ None Installed

Type _____ Diameter _____

Slot/Gauge _____ Length _____

Set Between _____ Ft. and _____ Ft.

PUMPING OR BAILING TEST

DETAILS	#1	#2	#3
Static Water Level (Ft. Below Grade)	125 ft		
Pumping Rate (GPM)	2		
Pumping Level (Ft Below Grade)	305		
Duration of Test (In Hours)	1		
Recovery Time to Static Level (In Hours)	2.17 min		

WELL HEAD

Pitless Adapter: Type, Make, Etc. To Be Installed By Owner

Well Cap: Type, Make, Etc. 6 5/8 Roger Conduit

Well Seal: Type, Make, Etc. _____

Well Platform: To Be Installed By Owner

Length _____ Width _____ Thickness _____

Grouting: ☒ Yes ☐ No
All Public Water Supplies must be grouted.

I hereby certify that this well was drilled and constructed under my supervision, in compliance with all requirements of the referenced permit, and that this record is true to the best of my knowledge and belief.

Melvin O Collis 007
Name Certification No.

Mtn State Water Well Drillers L.L.C.
Registered Business Name

Melvin O Collis 7/29/91
Signed Date

~~SS-177~~
Revised 1-71

WEST VIRGINIA
SEPTIC TANK INSPECTION FORM

Hampshire County Health Department Installation Permit No. ST-14-91-630

Name of Owner John F. Boose

Address 302 Denton Dr. Westminster, MD 21157

Property Address Cedar Grove Estates Lot #58

DESCRIPTION & NUMBER OF UNITS SERVED

Type Facility Served future house No. Water Closets —

Lot Size 4+ ~~sq. ft.~~ acres Area suitable for sewage disposal installation — sq.ft.

Source of Water Supply future well No. Lavatories —

No. Bedrooms 2 No. Showers or Tubs — No. Baths —

No. Garbage Grinders — No. Automatic Washers —

SEPTIC TANK

Material concrete Length — x Width — x Depth — = — cubic feet

Liquid Depth — ft. Liquid Capacity 1000 gal.

Distance to: Dwelling 40' Water Supply 100' Nearest Property Line 75'

SOIL ABSORPTION SYSTEM

Type Drain Line Material plastic Trench Width 36 Inches

Trench Depth 24 Inches Total Absorption area in Trench Bottom 900 sq. ft.

Diameter of Drain Line 4 Inches Type Filter Media gravel - 30 ton +

No. of Drain Lines 3 Depth Filter Media Under Drain Line 6 Inches

Length of Each Line 100, 100, 100, ft. Depth Filter Media Over Drain Line 2 in.

Distance of Disposal Field to: (a) Dwelling 30'

(b) Water Supply 100+' (c) Nearest Property Line 75'

An ~~inspection~~ of the septic tank system described herein disclosed that said system (MEETS, DOES NOT MEET) the minimum standards established by the West Virginia State Department of Health.

7-3-91
Date

Lee O'Hara
Sanitarian

SKETCH OF SYSTEM TO BE DRAWN ON BACK

Note: Copy of this inspection report must be given to owner and the original filed in the Health Department files. PERMANENT RECORD - DO NOT DESTROY.

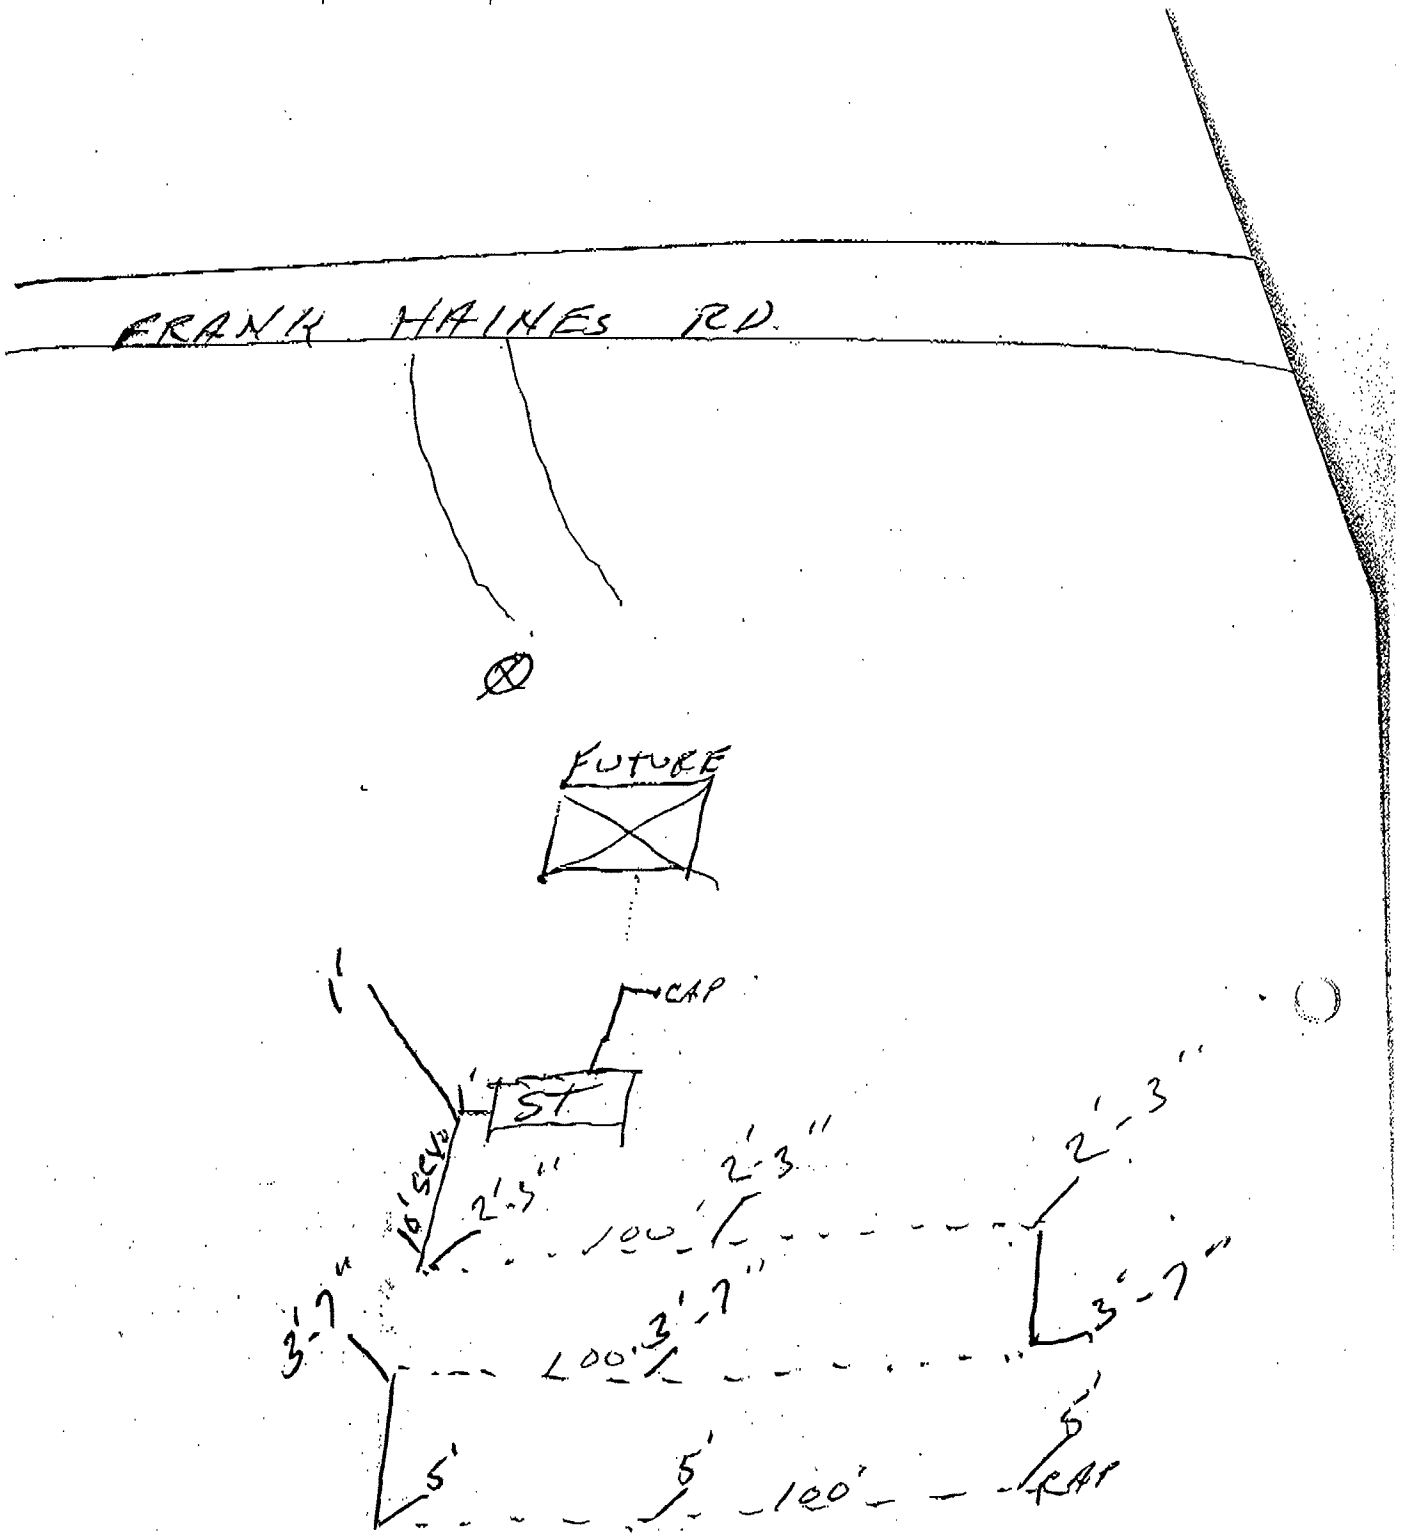
FRANK HAINES RD
FUTURE
1'
CAP
1'
ST
10' SCH 40
2'-3"
2'-3"
2'-3"
100'
3'-7"
3'-7"
100'
5'
5'
100'
CAP