

Mineral County Health Department  
Application for Environmental Site Evaluation



Name George Haller Phone 304-738-3418

Address RR 3 Box 113B Ridgely W.Va. 26753

Property Location HEAVENER ESTATE Ridgely W.Va.

Purpose of Site Evaluation slow pump  
septic systems

Steve call 301-616-3787  
Home 301-334-3789

I (we), the undersigned, certify that the information contained herein is correct and accurate to the best of my (our) knowledge. It is further understood that this form **is not** an application for a permit, and subsequent acceptance of this site by the Mineral County Health Department **does not** constitute a permit.

Signature Bodger Uphold

Date 8-17-07

**FOR HEALTH DEPARTMENT USE ONLY**

Date Received	Date Site Evaluation	Reviewed by	Date Fee Paid	Received From

Conditions Found \_\_\_\_\_  
\_\_\_\_\_  
\_\_\_\_\_  
\_\_\_\_\_  
\_\_\_\_\_

This is to certify that the Mineral County Health Department reviewed the contents of this form and conducted a site visit on the subject property. Based on the information provided it appears (if applicable) that the site ( ) is ( ) is not suitable for permit.

Signature \_\_\_\_\_

Date \_\_\_\_\_

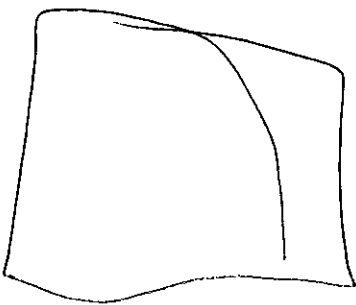
✓ 82



54 mps

1/4

GREEN  
VALLEY  
RAILS



To: Clearview Co. Inc.

Address: Rt. 2, Box 98A, Ridgeley, WV 26753

You are hereby issued a permit to install  
a small sewage disposal system consisting of a septic tank and soil absorption field  
and located at Behind Bunny Peer's shop

This small sewage disposal system shall meet the following specifications:

1. Septic Tank

a. Shall be made of concrete and not less than 1000  
gallon capacity.

2. Soil-Absorption System

a. Shall consist of 2 distribution lines 4" in diameter.

b. Each distribution line shall be 67 67  
feet in length

c. Each trench shall be 36 inch width with ZERO slope on trench bottom  
and ZERO slope on each distribution line.

d. No trench shall be more than 30 inches deep.

e. Total soil-absorption area in trench bottoms shall be 400 sq. ft.

f. Filter material shall be gravel and not greater than 1/2 - 2 1/2  
inches in diameter.

g. Filter material under each line shall be not less than 6 inches  
deep and not less than 2 inches over each distribution line.

h. Filter material shall be covered with untreated paper prior to backfilling.

i. Trenches shall be backfilled at least 6" above ground surface to provide  
for settling of backfill.

3. Other Small Sewage or Excreta Disposal Systems (Name the type system to be used,  
then use back of sheet to describe the details of the system.)

4. Special Requirements

a. Small sewage and excreta disposal systems shall be located at least 10 ft.  
from any property line and a minimum of 20 ft. from any stream or roadside cut.

b. Septic tanks shall be located at least 10 ft. and excreta disposal systems  
a minimum of 20 ft. from building foundation.

c. Septic tanks shall be located a minimum of 50 ft. and soil-absorption systems  
and excreta disposal systems a minimum of 100 ft. from any ground water supply  
or cistern.

5. This permit is not transferable and automatically expires 6 months after date  
of issue.

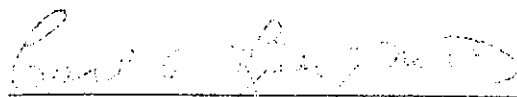
6. The applicant or his agent must notify this department, phone 788-1321 at  
least 48 hours before the system is ready for inspection.

7. All small sewage and excreta disposal systems must be inspected and approved  
prior to being covered with earth or otherwise put into service. Any applicable  
system or part thereof covered before being inspected shall be uncovered at the  
direction of the SANITARIAN.

8. This permit is NULL AND VOID when official inspection reveals conditions  
are different than those stipulated in this permit or if facts later become known  
that a health hazard would result by the installation of this system.

July 15, 1994

Date of Issue



Name

Mineral County

Health Department

Physician-Director, P/T

Title



788-1371

State of West Virginia

Mineral

HEALTH DEPARTMENT

FOR HEALTH DEPARTMENT USE ONLY

Date Recv'd. 7-15-94 Permit #: WW \_\_\_\_\_ ST \_\_\_\_\_  
Date Site Evaluated: 7-15-94

COUNTY: Mineral  
Coordinates: N \_\_\_\_\_ W \_\_\_\_\_  
Reviewed By: WPH

PART I

APPLICATION FOR PERMIT TO CONSTRUCT, MODIFY OR ABANDON A WATER WELL  
OR  
INSTALL OR MODIFY A SMALL SEWAGE DISPOSAL SYSTEM

Instructions: Part I of this application is to be completed by the owner. State and county health department regulations require that water wells and sewage disposal systems be located, designed and constructed in accordance with published standards.

Property Owner: Clearview Co. Inc.  
(please print)

Address: Rt. # 2 Box 98A, Ridgeley, West Va. 26753

Date: July 12, 1994 Telephone: (home) 304-298-3869 (business) 304-738-2220

☐ Water Well ☒ Sewage Disposal System

LOCATION OF PROPERTY (be specific) Up behind Bunny Peer's Shop

Name of Subdivision: Crest-Wood Section: A Lot: 6

Size of Lot: 4.25Ac sq.ft./acres ☒ Residence; No. of Bedrooms 2 No. of individuals served: 2  
☐ Other: \_\_\_\_\_

Property Deed Recorded in Book No.: 6 (205-188) Page: 26 Date Recorded: November 22, 1976

To the best of my knowledge, the information provided on this application is true and I understand that I am responsible for informing the well driller and sewage system installer of the existing or proposed locations of sewage systems and well. I further understand that it is my responsibility to consult the sanitarian for assistance as necessary and to determine the location of the existing sewage system or well if said location is presently unknown to me.

G. Edward Keenan  
(signature of owner)

\*\*\*\*\*

PLEASE PROCEED TO COMPLETE PARTS II AND III, IF NECESSARY

\*\*\*\*\*

PART II  
WATER WELL INFORMATION

Water well will be \_\_\_\_\_ constructed \_\_\_\_\_ modified and will be used for \_\_\_\_\_ potable water, \_\_\_\_\_ water exploration, \_\_\_\_\_ abandoned or other purposes: \_\_\_\_\_

Well Driller: \_\_\_\_\_ Phone No.: \_\_\_\_\_

Business Address: \_\_\_\_\_



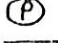
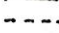
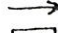
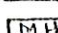


 
Type of Casing: \_\_\_\_\_

Distance of Well from Potential Sources of Contamination:

Streams, Rivers & Impoundments _____	Sewers & Drains (non-waterlight) _____	Privies (vault) _____
Sewage Absorption Fields _____	Sewers & Drains (hydrostat. tested) _____	Barnyard/Feeding _____
Septic Tank _____	Sewage Holding Tank _____	Water Areas _____
Other: _____		

SIGNATURE of DRILLER \_\_\_\_\_ CERTIFICATION # \_\_\_\_\_ DATE \_\_\_\_\_

Please draw a sketch of the property showing existing or proposed well location, location of structures, existing or proposed sewage systems within 200 feet of well location, slope of site and lot dimensions. Locate animal pens, barnyards or any other factors which can be a possible source of contamination for the water supply.

	House		Water Supply		Percolation Test Site
	Soil Absorption Line		Dir. of Ground Slope		Property Line
	Trees		Septic Tank		Mobilehome



\*\*\*\*\*

### PART III SEWAGE DISPOSAL SYSTEM INFORMATION

☒ Install ☐ Modify  
☒ Septic Tank ☒ Absorption Field ☐ Holding Tank ☐ Pit Privy ☐ Vault Privy  
☐ Chemical/Composting Toilet ☐ Alternate System (attach detailed plans)  
 Other \_\_\_\_\_

#### DESCRIPTION OF PROPOSED SYSTEM:

Septic Tank: Capacity 1000 Material Concrete Nearest Prop. Line 100 ft.  
 Absorption Field: 400 Sq. ft. with 2 lines and 67 long  
 Pipe ASTM No. 1500 crush proof Nearest Property Line 710  
 Type of Water Supply: Public Area Suitable for Absorption Field: 10,000 Sq. ft.

Six-foot hole free of water or solid rock? ☒ Yes ☐ No

#### PERCOLATION TEST:

TEST HOLE: #1 29 minutes #2 41 minutes #3 34 minutes #4 31 minutes

Total minutes 134, divided by 24 = 5.62 average time for water to fall one inch.

Test done on July 6 1994 (date) using approved procedures outlined in the Design Standards.

Signed: [Signature]

[Signature]  
Signature of Installer

54-80-168  
Certification No.

July 12 1994  
Date